


T.25S. R.35E.W.M.

T.24 & 25S. R.35E. W.M.

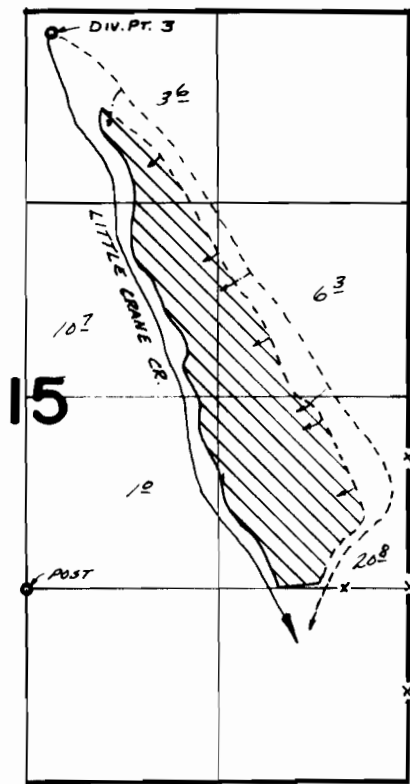

POINTS OF DIVERSION:

- DAM - 1050'S ± 400'E From NW Cor. Sec. 27
- Div. Pt. 1 - 1080'S ± 1620'W From NE Cor. Sec. 28
- Div. Pt. 2 - 250'S ± 300'E From NW Cor. Sec. 34
- Div. Pt. 3 - 150'S ± 160'E From N 1/4 Cor. Sec. 15

# FINAL PROOF SURVEY

UNDER

APPLICATIONS	R-37250 PERMITS	R-4580
	37251	30444 -
	R-43979	R-5065
	43980	32859
	46431	34691 -

Cert. 6933  
IN THE NAME OF

R.H. EMMERSON & SON

SURVEYED OCT. 20, 1977 BY L.H. NUNN

