


T.36 S., R.4 W.
 Scale 1 inch = 200 feet
 RIVERDALE TRACTS

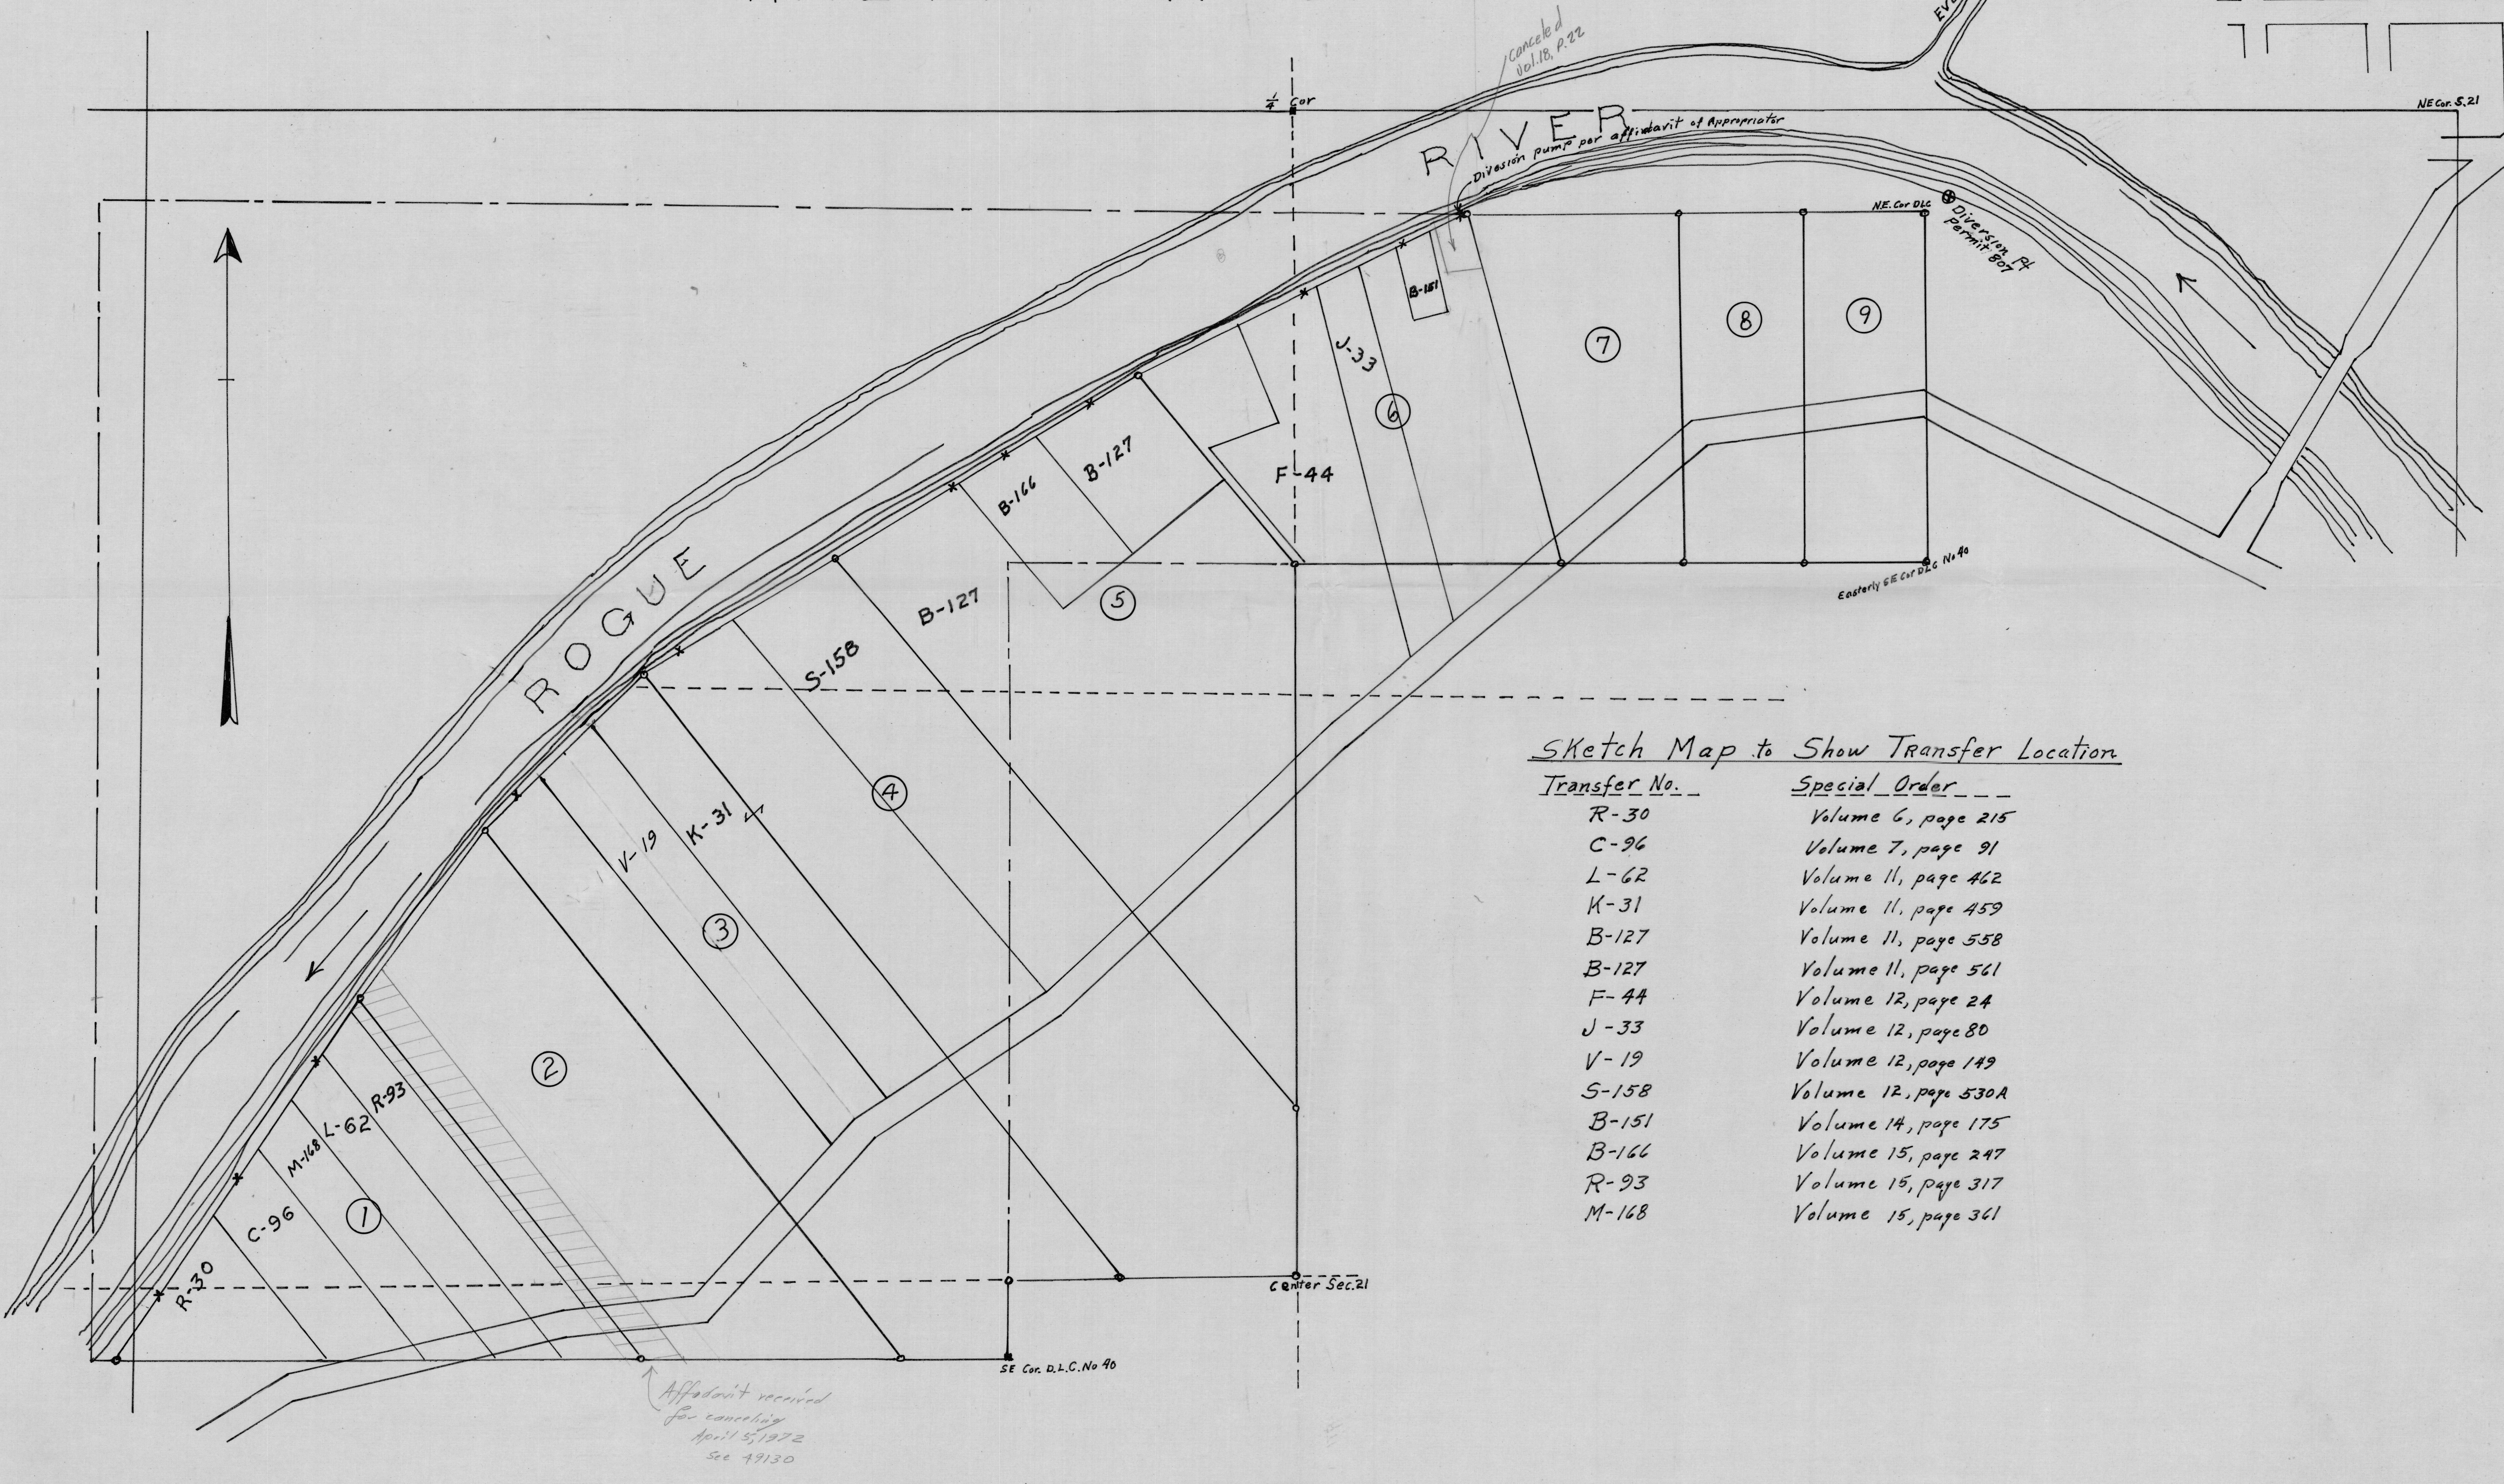

Sketch Map to Show Transfer Location

<u>Transfer No.</u>	<u>Special Order</u>
R-30	Volume 6, page 215
C-96	Volume 7, page 91
L-62	Volume 11, page 462
K-31	Volume 11, page 459
B-127	Volume 11, page 558
B-127	Volume 11, page 561
F-44	Volume 12, page 24
J-33	Volume 12, page 80
V-19	Volume 12, page 149
S-158	Volume 12, page 530A
B-151	Volume 14, page 175
B-166	Volume 15, page 247
R-93	Volume 15, page 317
M-168	Volume 15, page 361