


6-3893

48262

T.35S.,R.12E.,W.M.

Sycan Co. W. Sycan Marsh Well

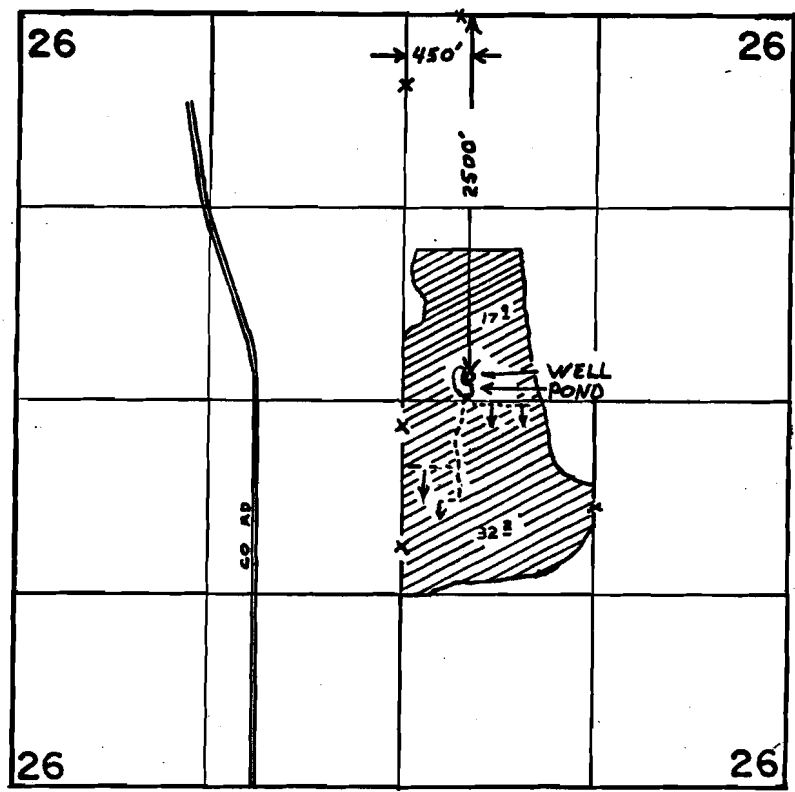

FINAL PROOF SURVEY UNDER

Application No. G-4146 Permit No. G-3893
IN NAME OF

ALEX WILLIAMS

Surveyed OCT. 19, 1977, by R.G. MUCKEN