
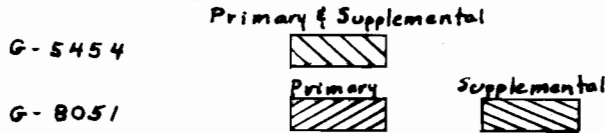


T.16S. R.4W., W.M.

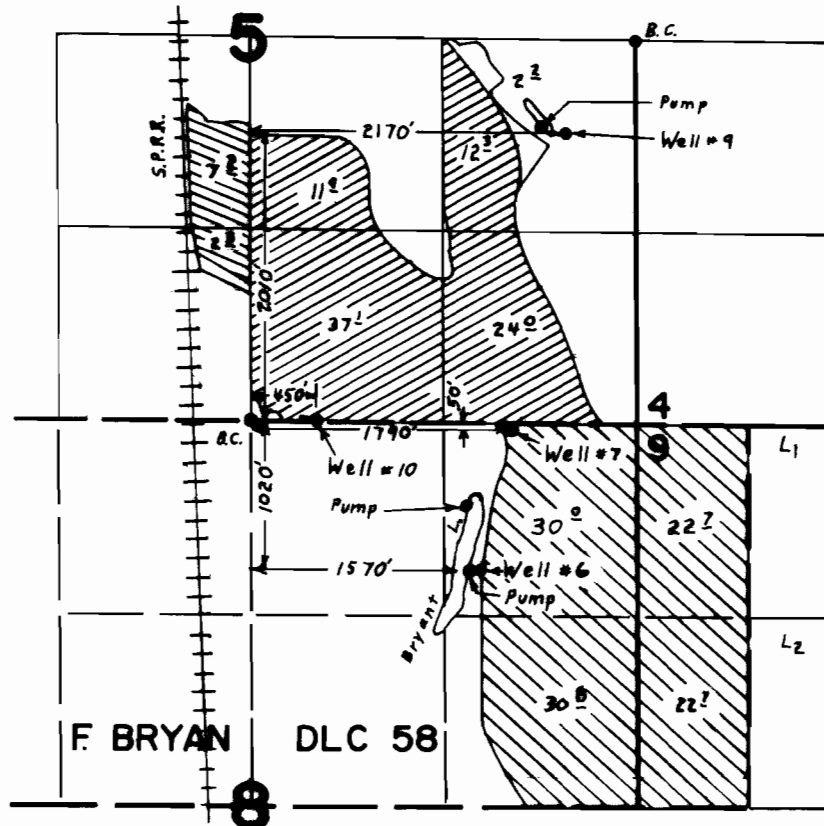

FINAL PROOF SURVEY UNDER

G-5454 G-5369
 Application No. G-8051... Permit No. G-7934.
 IN NAME OF

.....GAYLE D. STROME.....

Surveyed APR...27, 1978., by J.S.DONALDSON
 MAY 10, 1978 L. H. NUNN