



T. 16 S., R. 4 W., W.M.

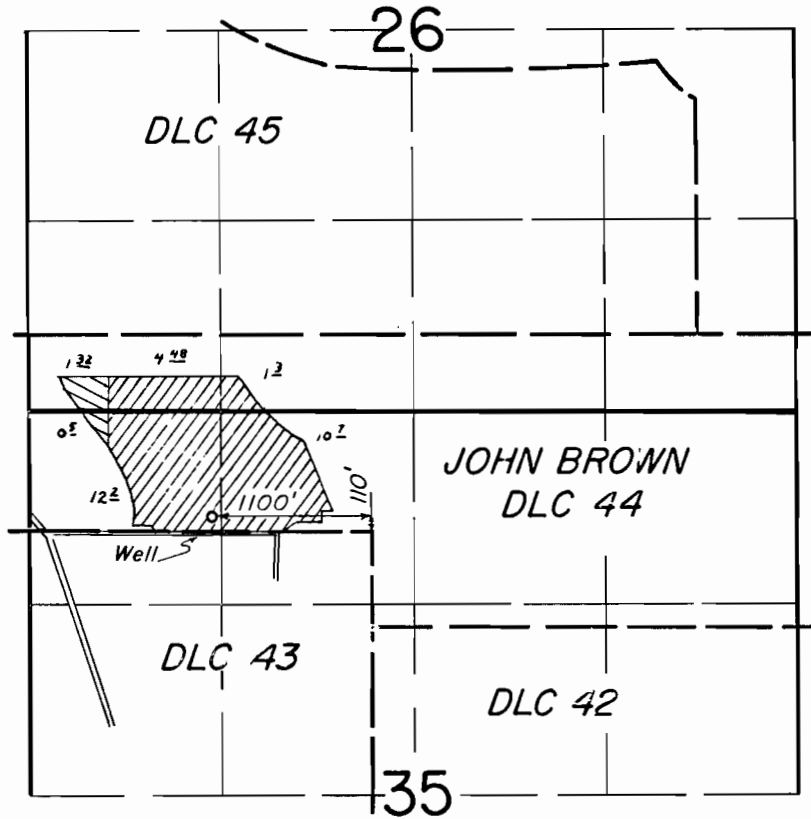

FINAL PROOF SURVEY
UNDER

Application No. G-9303 Permit No. G-9439
G-6952 G-6467 
IN NAME OF

Randy R. Henderson

Surveyed MAY 10, 1978, by L. NUNN
June 16, 1982 L.M. Toll

