





# T.16S. R.4 W., W.M.

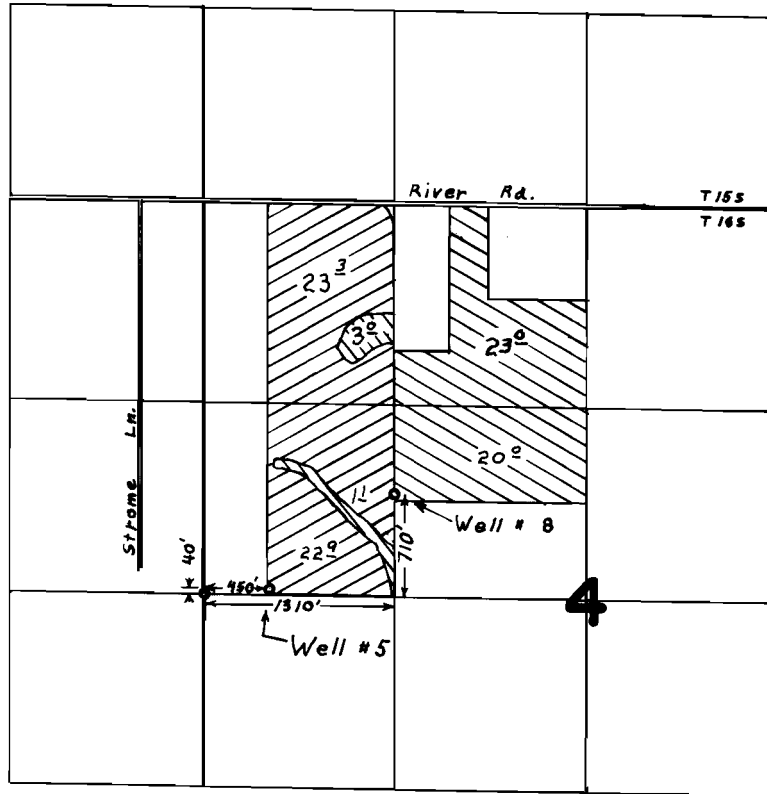

-  Primary - Wells # 5 & 8
-  Supplemental - Wells # 5 & 8
-  Supplemental - Well # 8

## FINAL PROOF SURVEY UNDER

Application No. G-8050. Permit No. G-7457.  
IN NAME OF

.....GAYLE D. STROME.....

Surveyed APR...27. 1978., by J.S.DONALDSON