


T. 16 S., R. 8 W., W.M.

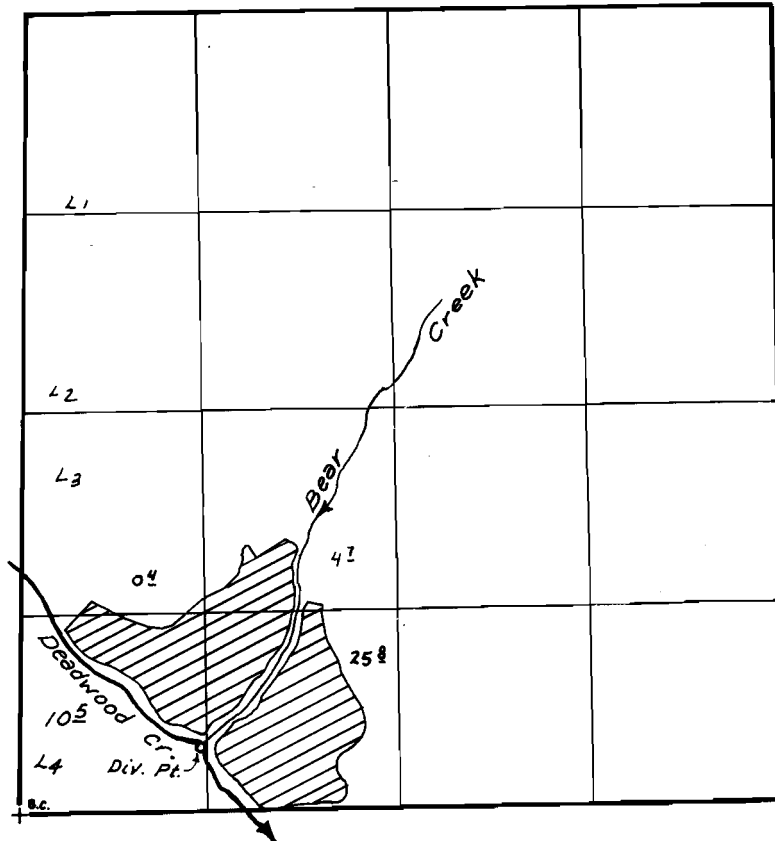

DIV. PT. LOC: 450' N. & 1240' E. from SW. Cor. Sec. 30

FINAL PROOF SURVEY UNDER

Application No. 39873 Permit No. 29688
IN NAME OF

Jonathan W. & Elizabeth T. Morris

Surveyed May 18, 1976, by D.M. Norby