


T.17S.,R.6W.,W.M.

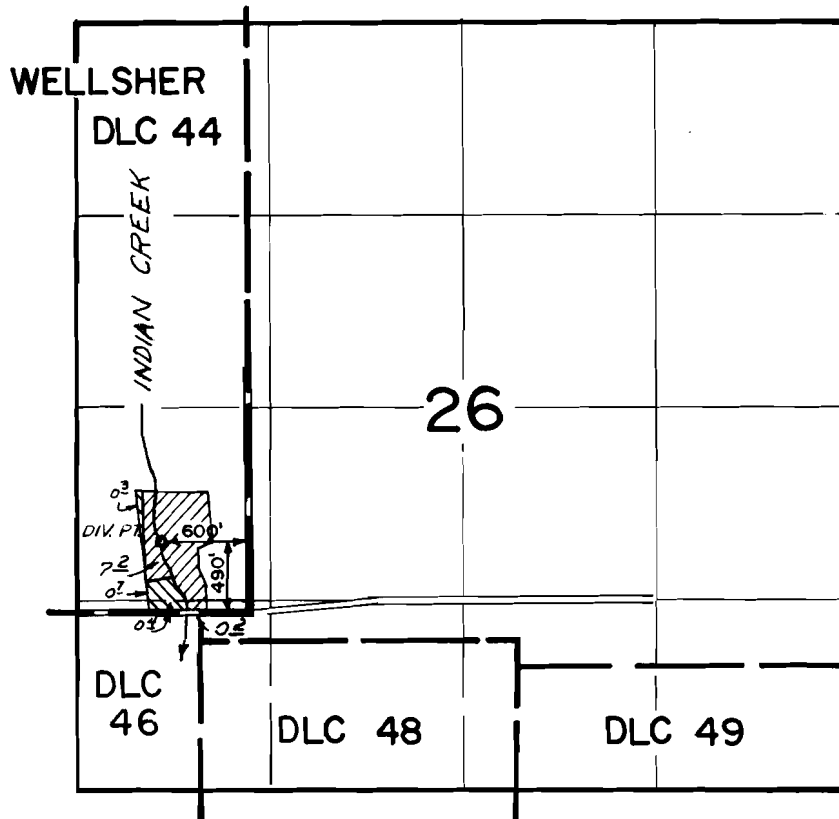

FINAL PROOF SURVEY
UNDER

Application No. 54403 50463 Permit No. 40768 38114
IN NAME OF

William Walter McCoy

Surveyed May 12, 1978 by L. Nunn
May 4, 1982 L. M. Toll

DBQ-15J-23 44r
1978-P & DBQ-15J-102 Jlf