


T. 18 S., R. 7 W., W.M.

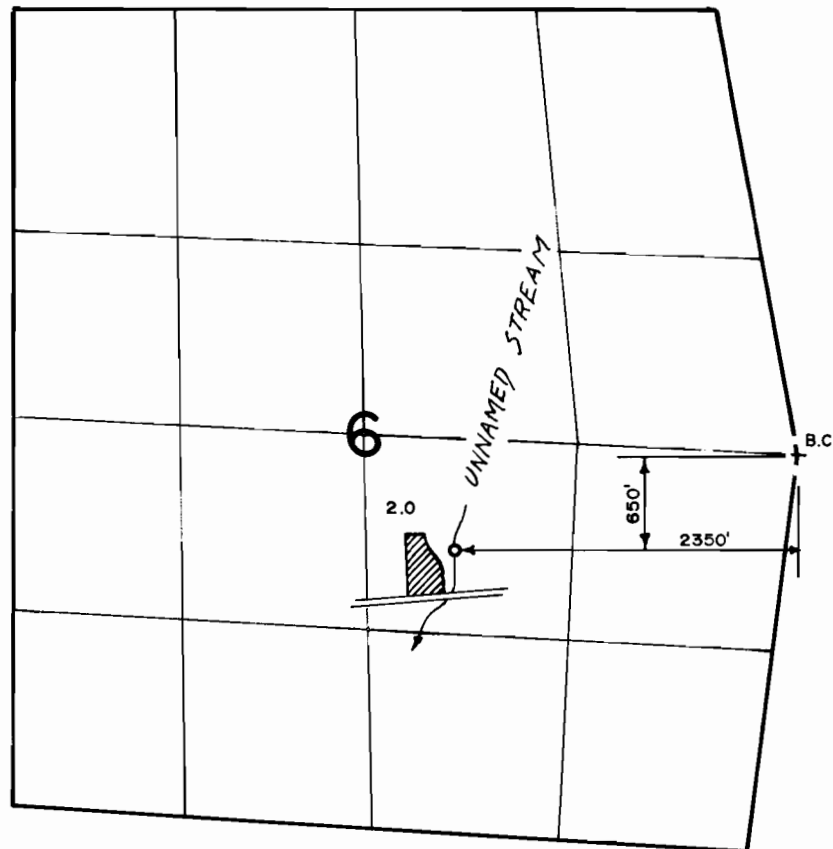

FINAL PROOF SURVEY
UNDER

Application No. 51929 Permit No. 39068
IN NAME OF

Samuel W. North, Jr.

Surveyed May 24, 1978, by L. Nunn

DBQ-3JJ-235 *jb*