


T. 17 S., R. 6 W., W.M.

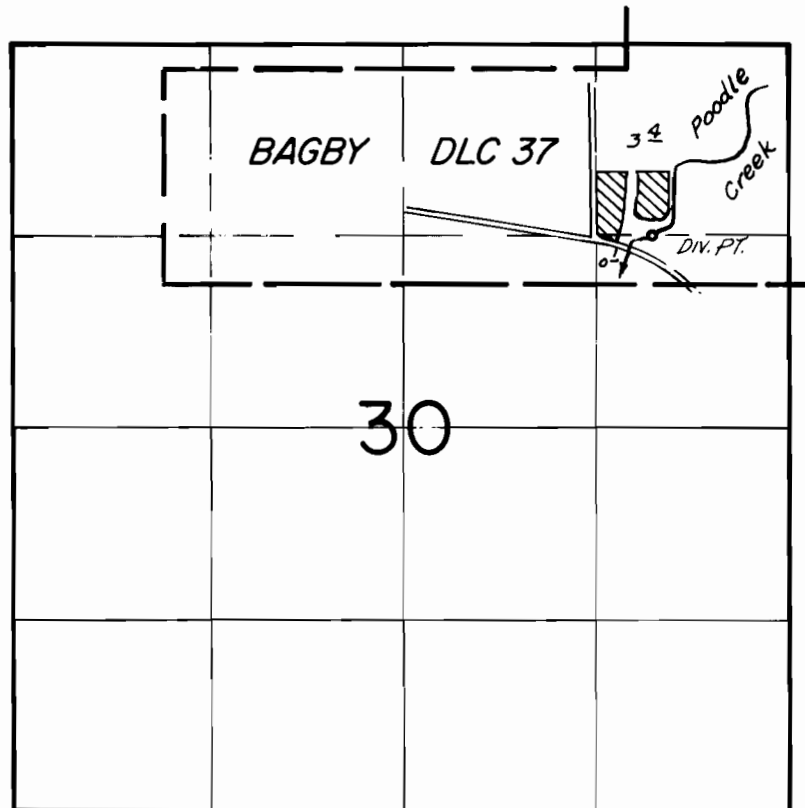

DIV. PT. LOC.: 1320'S. & 930'W. from NE Cor. Sec. 30

FINAL PROOF SURVEY
UNDER

Application No. 52655 Permit No. 39679
IN NAME OF

Orville C. Moore

Surveyed May 12, 1978 by L. Nunn

DBQ-8H-168 dCB