


T.16S.,R.7W.,W.M.

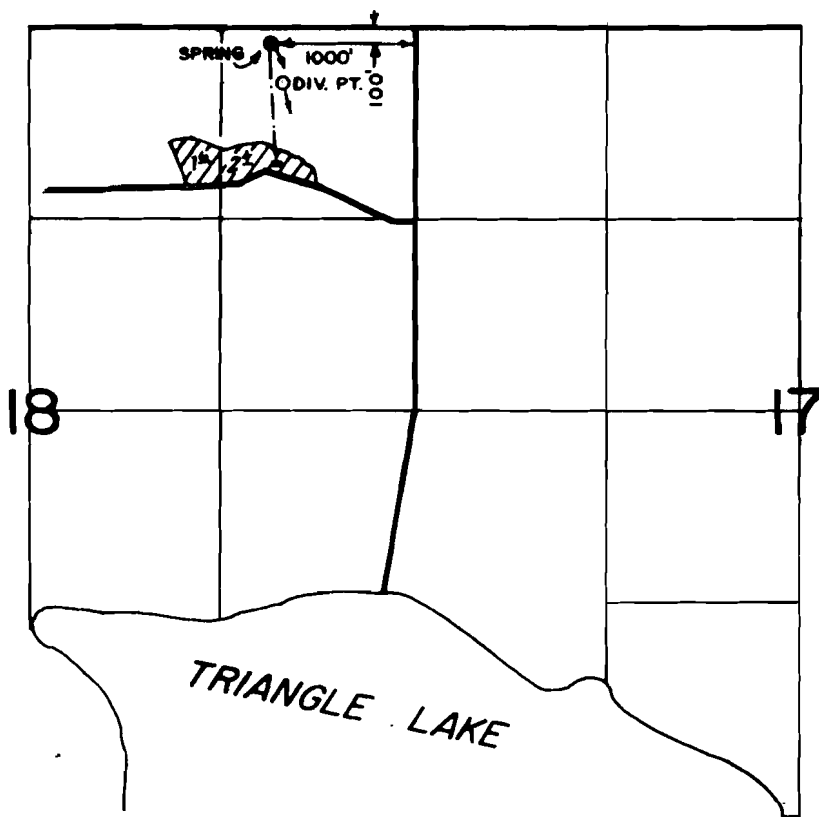

DIV. PT. LOC.: 370' SOUTH & 900' WEST FROM THE N.E. COR.
SEC. 18.

SCALE: 1" = 1320'

FINAL PROOF SURVEY
UNDER

61661 46103
Application No. 54304 Permit No. 40661
IN NAME OF

ROBERT WALKER & PAULA LYNETTE THOMAS

Surveyed MAY 25, 1978 by L. NUNN
MAY 8, 1985 by P. R. PAGTER