


T. 9 S., R. 10 W., W.M.

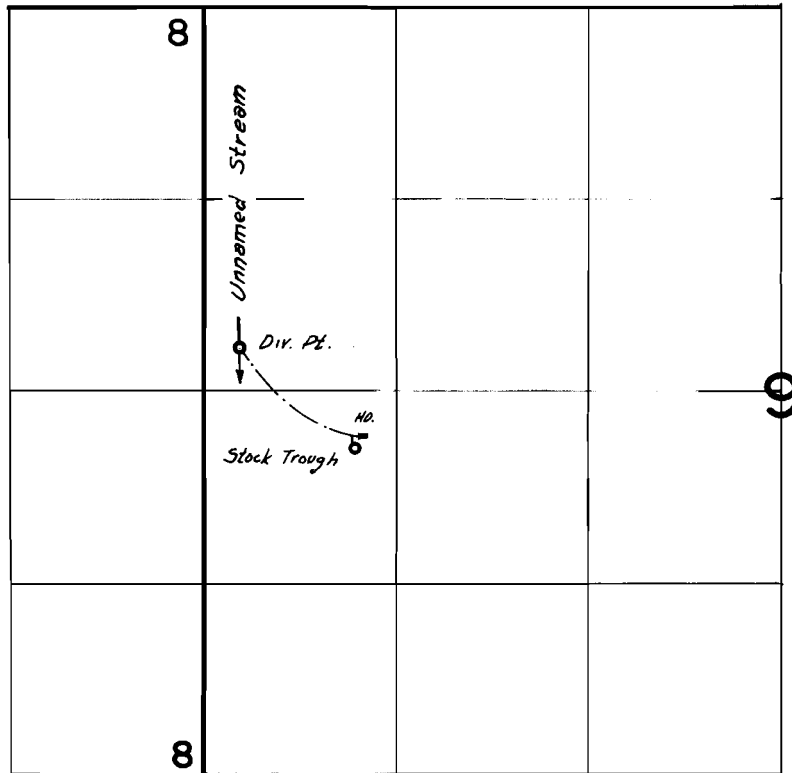

Div. Pt. Loc.: 300' N. & 250' E. from W. $\frac{1}{4}$ Cor. Sec. 9

FINAL PROOF SURVEY
UNDER

Application No. 54501 Permit No. 40875
IN NAME OF

Mildred J. Kirchhof

Surveyed May 17, 1978, by L. Nunn