


# T.13S.R.1E.W.M.

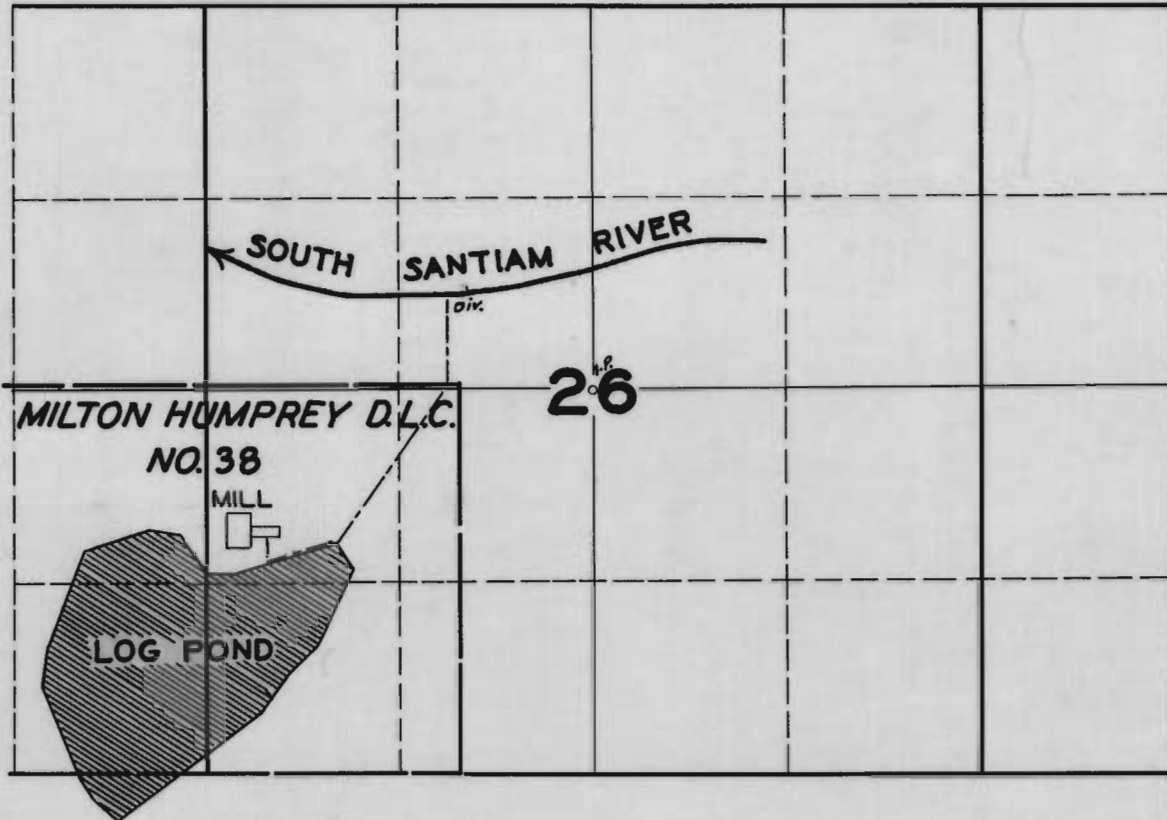

## FINAL PROOF SURVEY

UNDER

R-21568

R-841

Application No. 21569 Permit No. 16948

IN NAME OF

WILLAMETTE NATIONAL LUMBER CO.

Surveyed SEP. 2, 1947, by JAS. E. BUNNELL