


T. 16 & 17 S. R. 2 W. W.M.

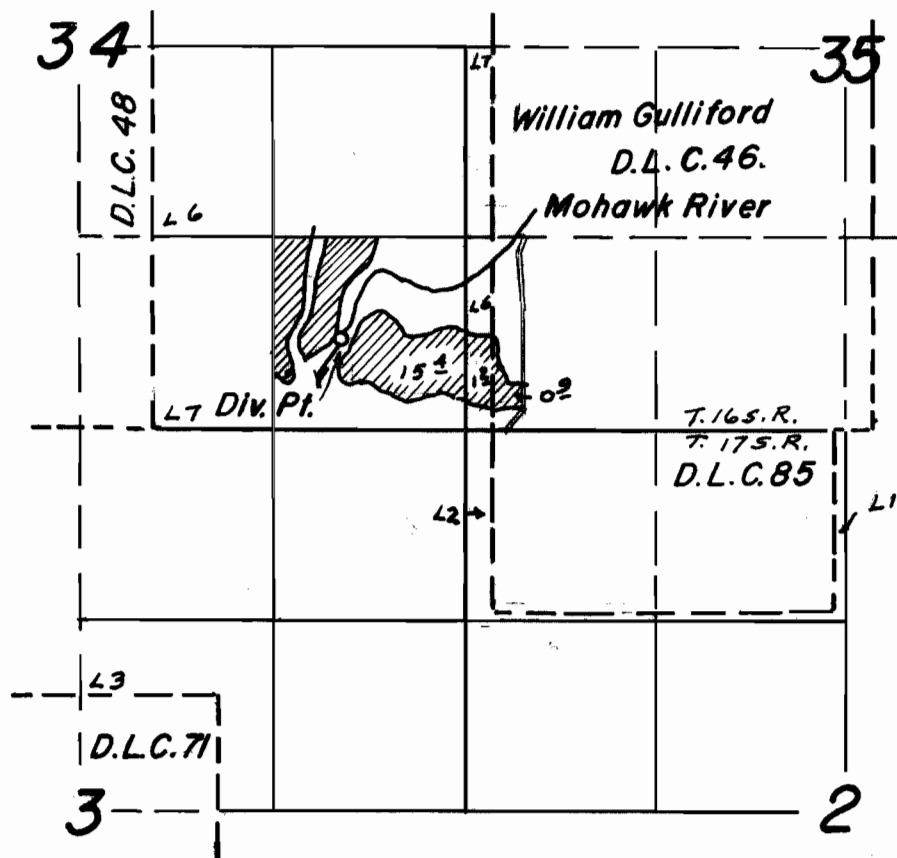

FINAL PROOF SURVEY
UNDER

Application No. 33271 Permit No. 26344
IN NAME OF

Vance E. & Ruby E. Strunk

Surveyed June 24 1963, by T. Lauer