


T.14S. R.42E. W.M.

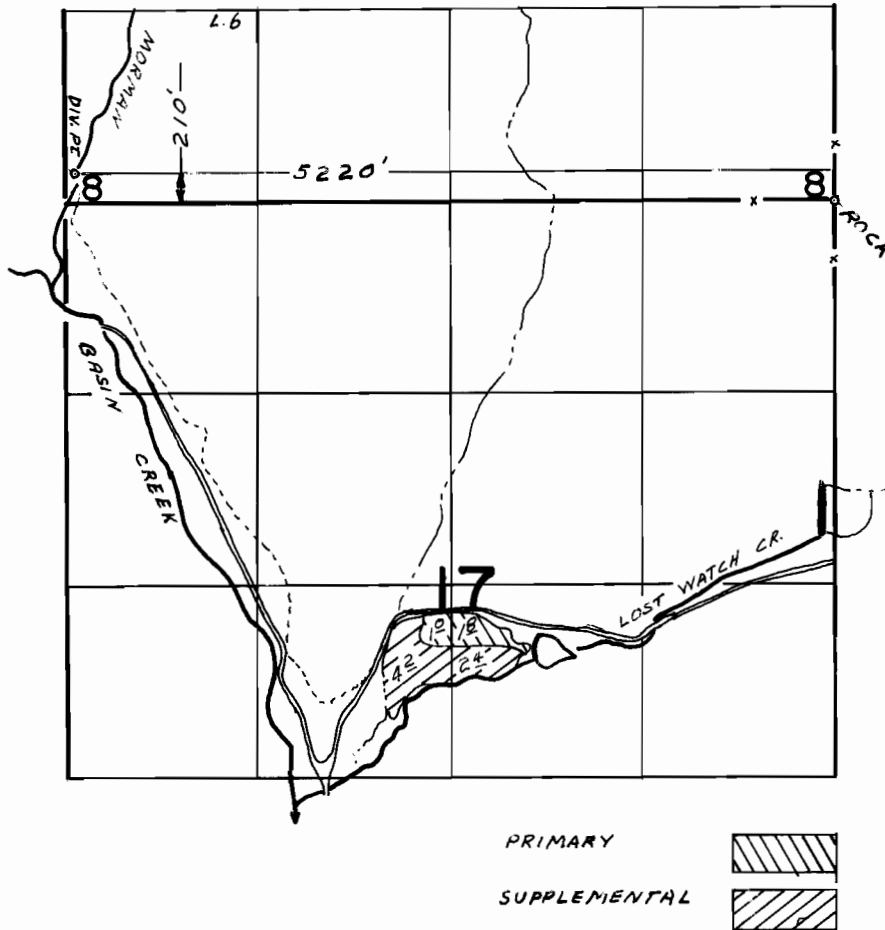

FINAL PROOF SURVEY
UNDER

Application No. 49233 Permit No. 37903
IN NAME OF

PHILIP & HORTON WORSHAM

Surveyed JUN 24 1978, by L.H. NUNN