


T14S. R.42E. W.M.

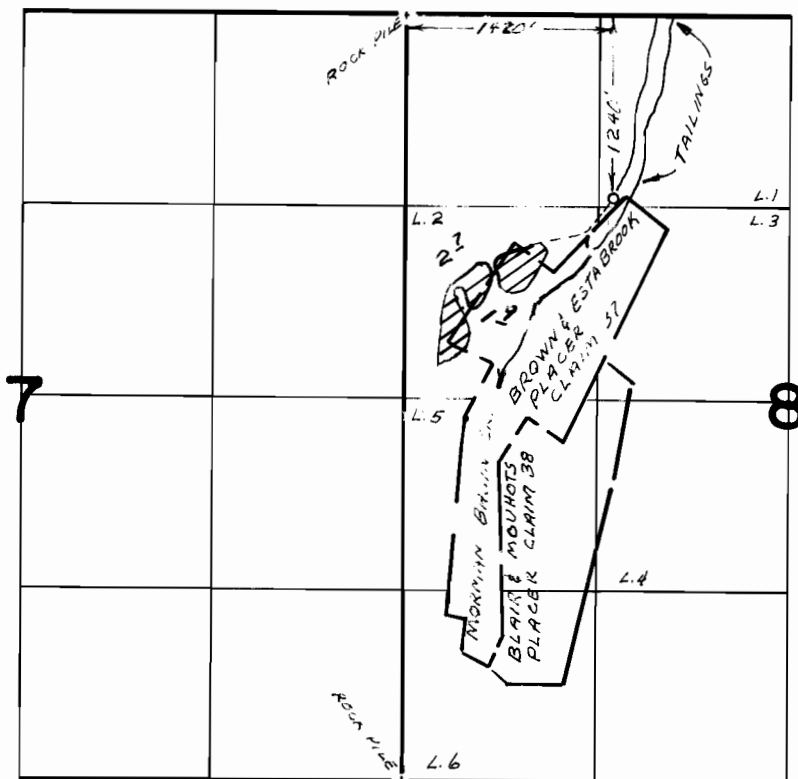

FINAL PROOF SURVEY
UNDER

Application No. 49234 Permit No. 37904
IN NAME OF

HORTON & PHILIP WORSHAM

Surveyed JUN.24. 1978., by L.H. NUNN.....