


T.17S. R.47E. W.M.

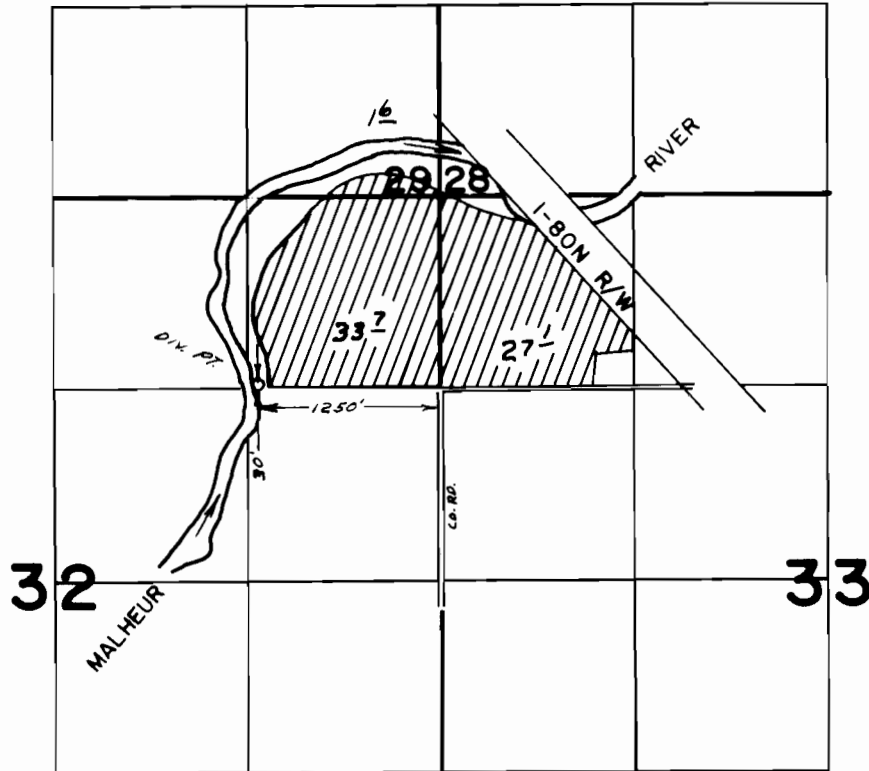

FINAL PROOF SURVEY
UNDER

Application No. 51275..... Permit No. 37738.....
IN NAME OF

.....**ROBERT CRUICKSHANK**.....

Surveyed JUN 26 1978, by L.H. NUNN.....