


T.14S. R.42E. W.M.

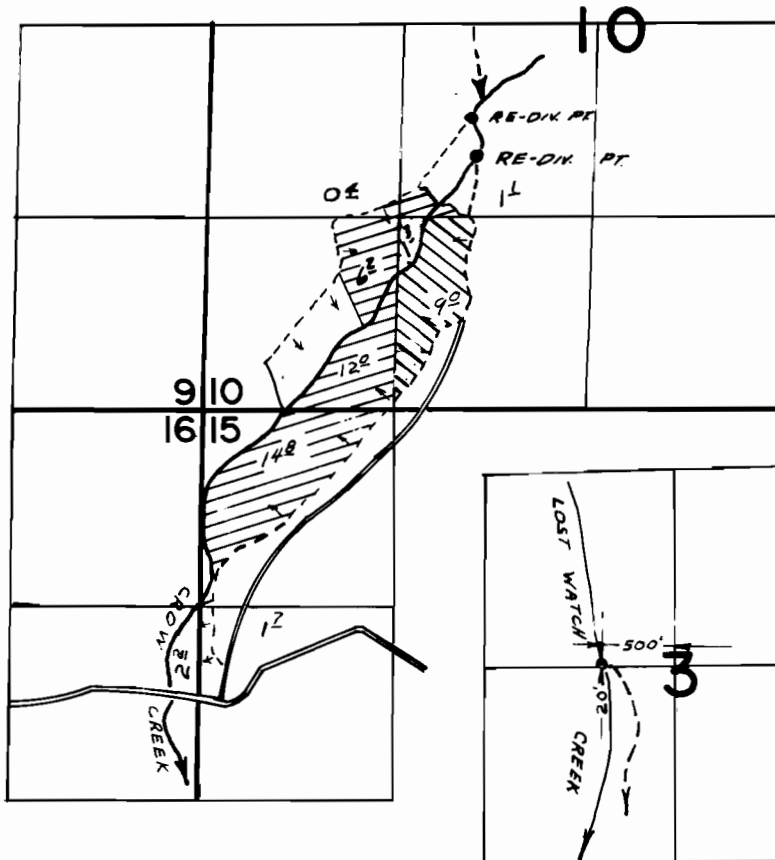

FINAL PROOF SURVEY

UNDER

Application No. 51555..... Permit No. 38897.....
IN NAME OF

HORTON & PHILIP WORSHAM

Surveyed JUN 24 1978, by L.H. NUNN