


T.6S. R.1W, W.M.

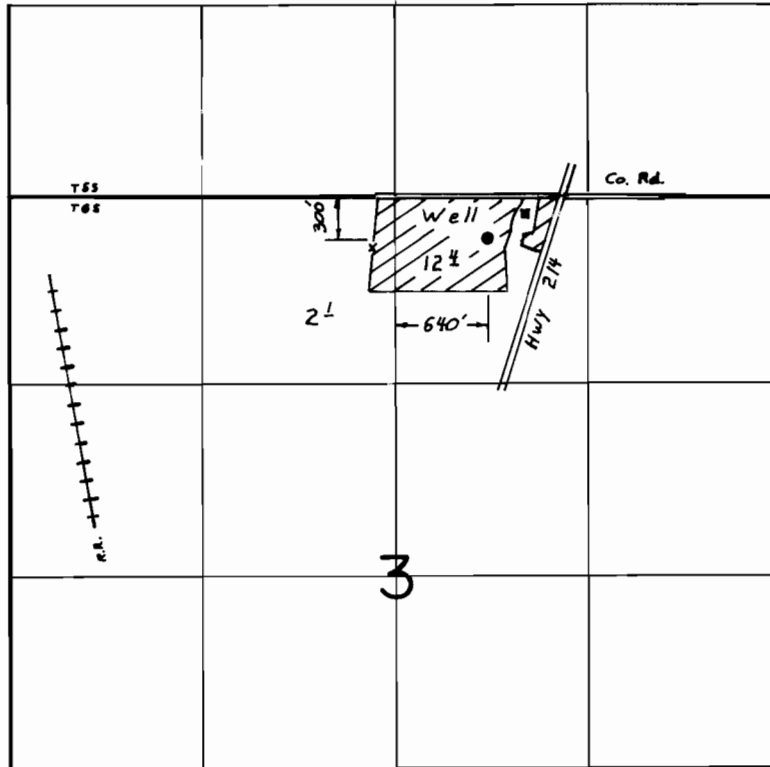

FINAL PROOF SURVEY
UNDER

Application No. G-6967.. Permit No. G-6478..
IN NAME OF

.....IVAN SIBIRZEW.....

Surveyed SEPT. 9. 1977., by B.R.SUND.....