


G-6296
48296

T. 1S. R. 24E. W.M.

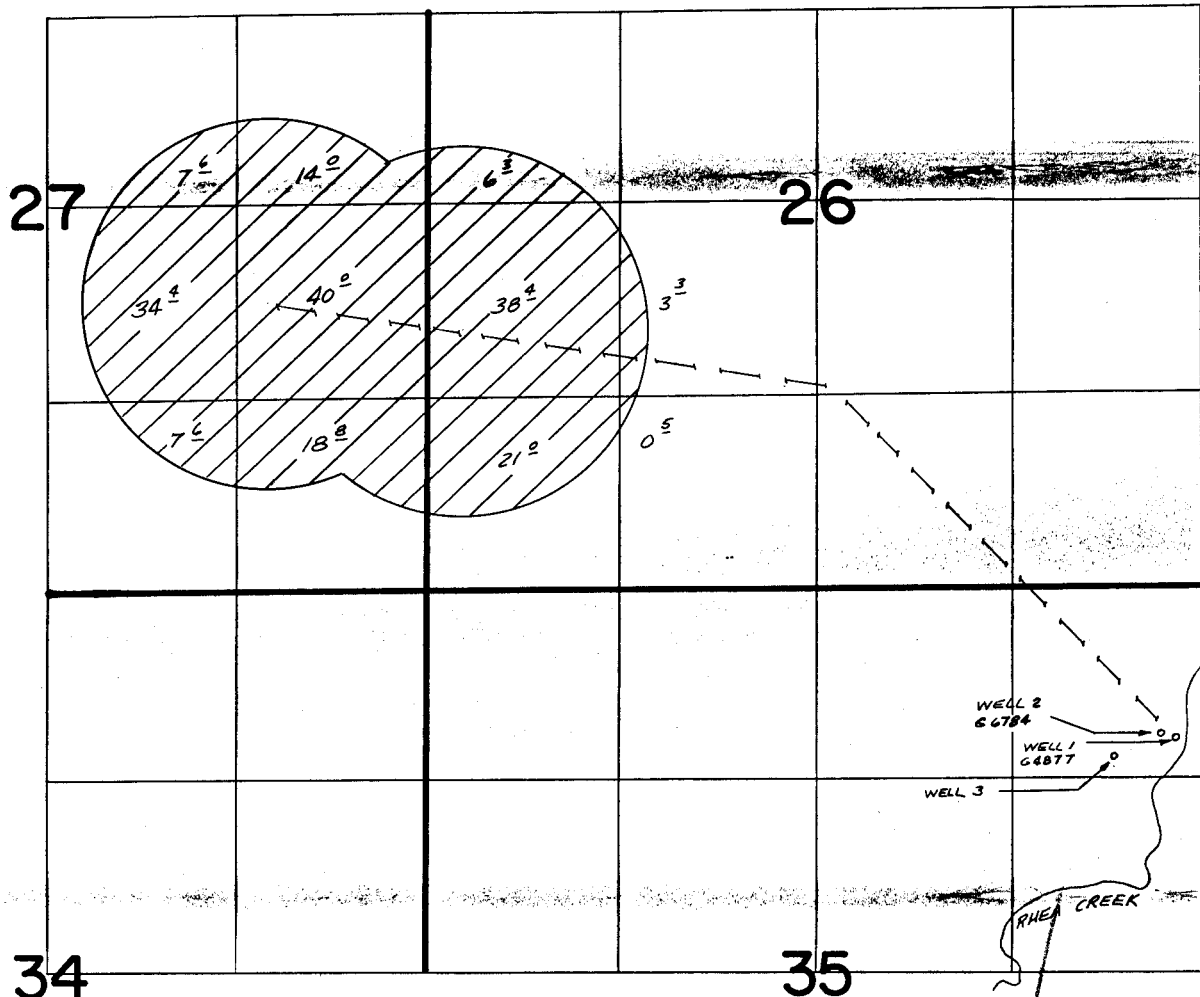

WELL 1 LOCATED 1050' S. & 210' W. FROM NE COR SEC 35
WELL 2 LOCATED 1020' S. & 300' W. FROM NE COR SEC 35
WELL 3 LOCATED 1180' S. & 620' W. FROM NE COR SEC 35

FINAL PROOF SURVEY UNDER

Application No. G.6784... Permit No. G.6296....
IN NAME OF

DARRELL PADBERG

Surveyed SEPT. 12, 1978. by R. BARWIN....

AAC-3FF-265
PTS-1978-P-D