


T.7S. R.4W. W.M.

RECEIVED

APR 09 1979

WATER RESOURCES DEPT.  
SALEM, OREGON

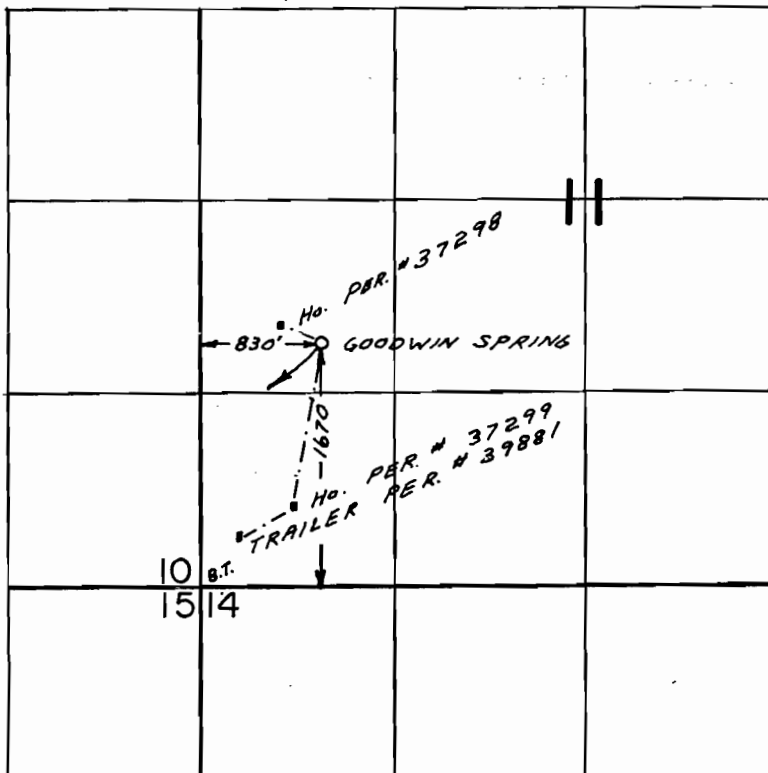

**FINAL PROOF SURVEY**  
UNDER

51808

37298-PORTER

51809

37299-FITTS

Application No. 52831..... Permit No. 39881...FITTS

IN NAME OF  
DAVID H. PORTER &  
FRANK C. FITTS

Surveyed APR. 14... 1975., by L.H. NUNN.....

OCT. 7 1976 C.R. KING