


T.7S.R.4W. W.M.

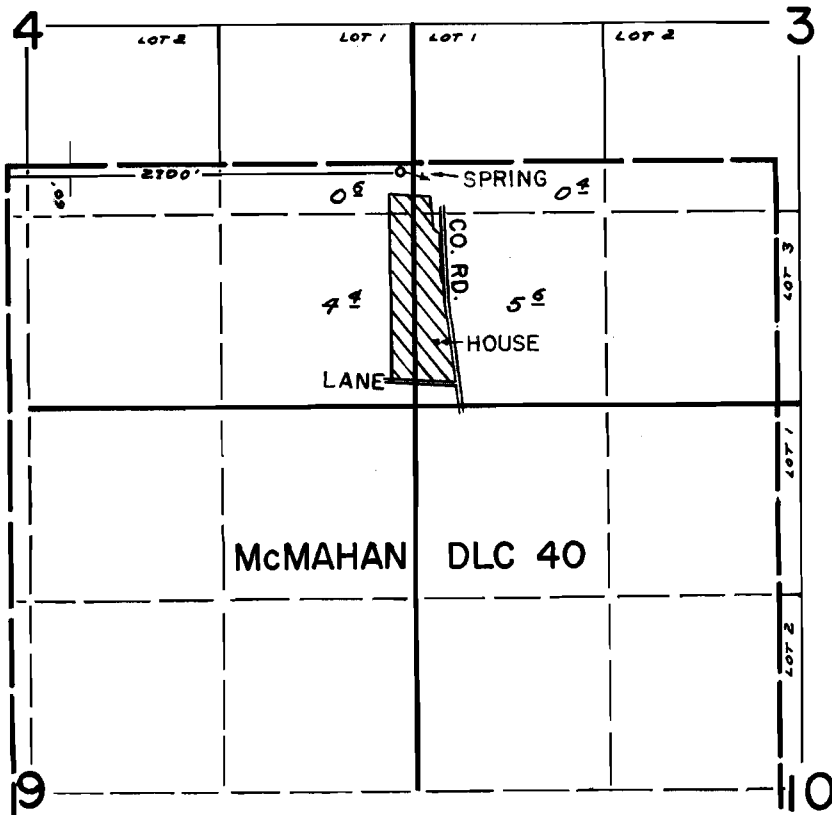

**FINAL PROOF SURVEY**  
UNDER

Application No. 40830 Permit No. 30418  
IN NAME OF

**STAN KLIMCZAK**

Surveyed JUNE 30 1969, by D. R. BUELL