


RECEIVED

JUL 10 1975

WATER RESOURCES DEPT.
SALEM, OREGON

T.I.S.R. 9W.W.M.

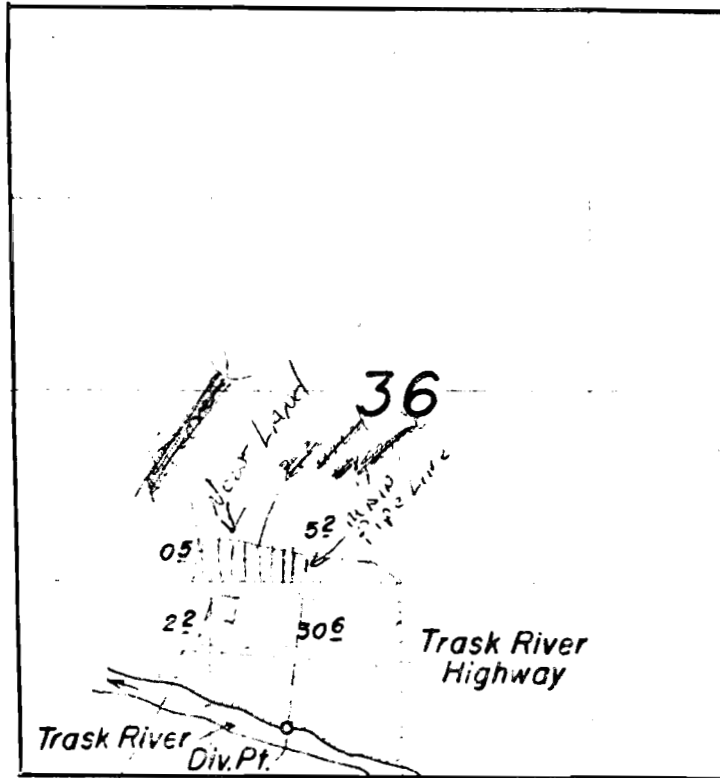

Application No. 53402
Permit No. 39744

FINAL PROOF SURVEY
UNDER

Application No. 37666 Permit No. 28075
IN NAME OF

Dale C. Turner

Surveyed July 30, 1963 by C. Baker