


G-6164  
48307

T.2N.,R.33E.,W.M.

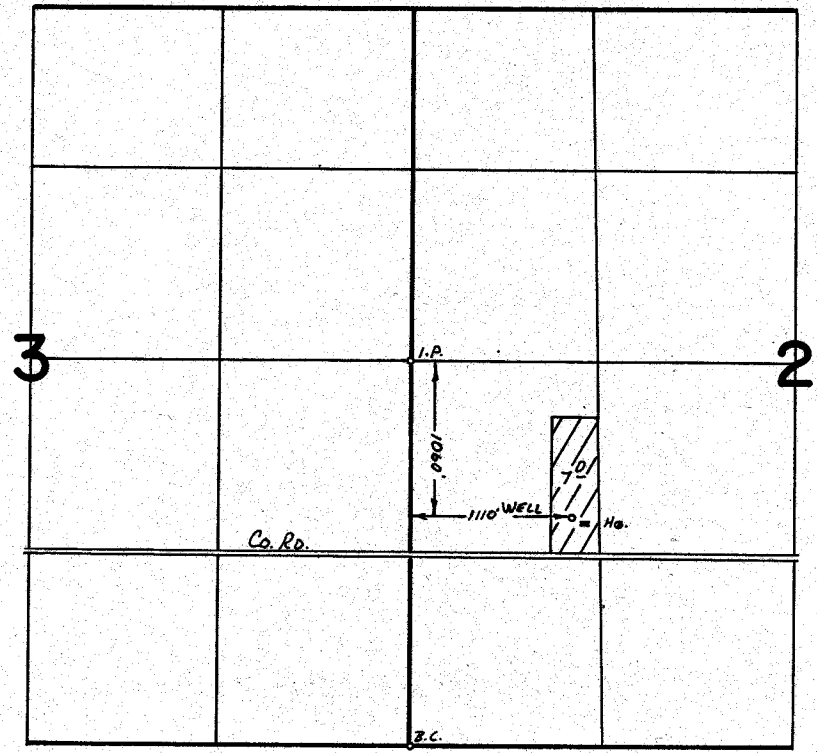

**FINAL PROOF SURVEY**  
UNDER

Application No. ..G-6563. Permit No. ..G-6164..  
IN NAME OF

.....**NORMAN BEEN**.....

Surveyed *APRIL 7* 197*6*, by *L. Toll*.....