


B G-481
48308
28728

T.4N.R.29E.W.M.

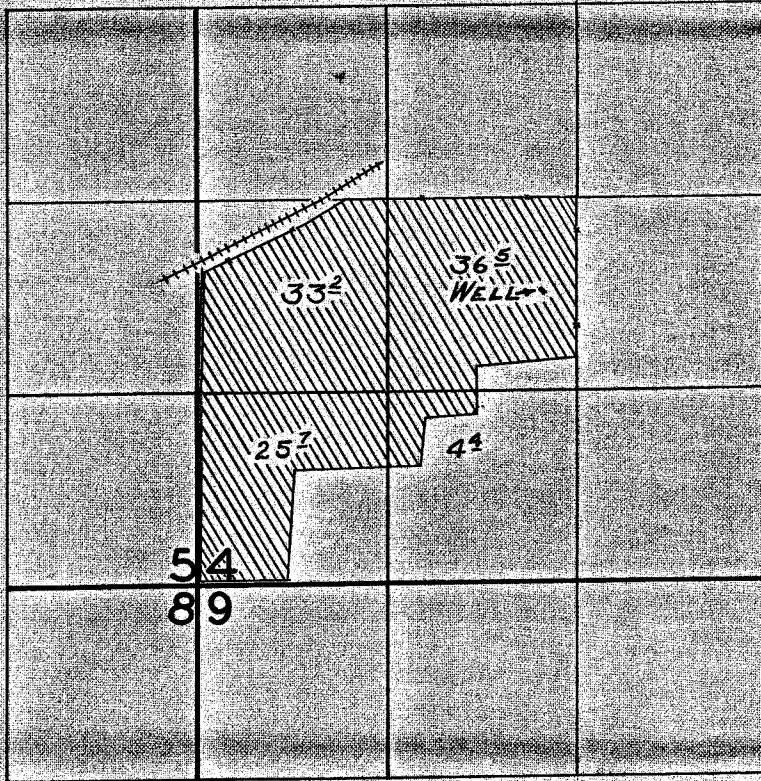

FINAL PROOF SURVEY UNDER

Application No. G-588... Permit No. G-481...
IN NAME OF

JOHN F. WALCHLI

Surveyed Nov. 17, 1960, by M. BISH

NZ-9F-46
NZ-1P-127

R