


T.1S.R.2W.W.M.

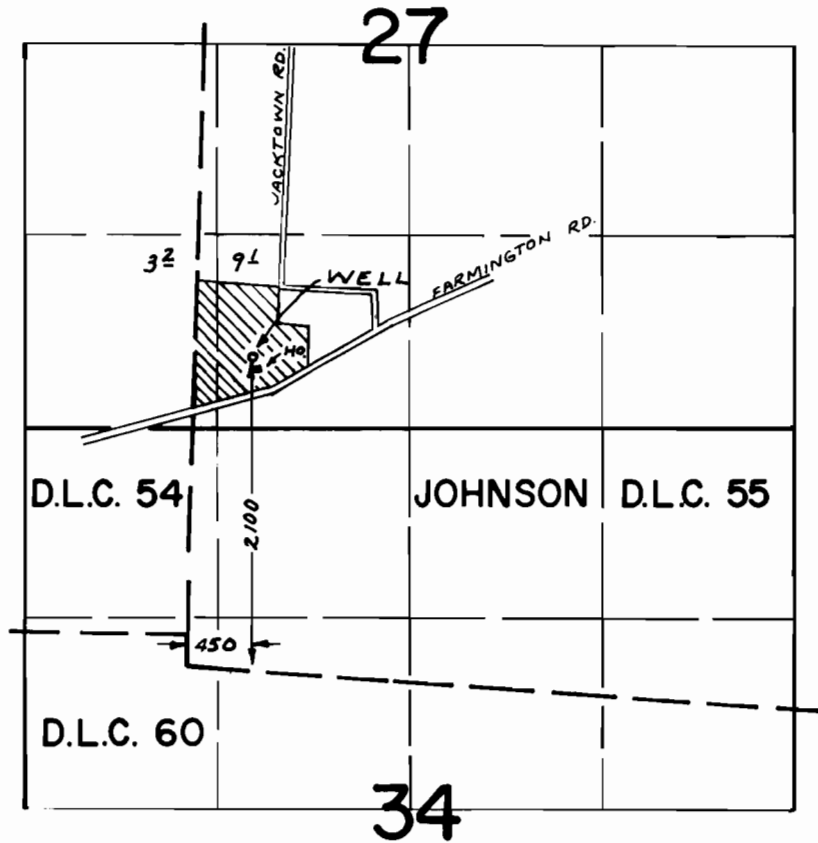

FINAL PROOF SURVEY UNDER

Application No. G-6658 Permit No. G-5266
IN NAME OF

GARY D. POOLE

Surveyed SEPT. 28 1977, by R. G. MUCKEN