


T. 1 S. R. 2 W. W. M.

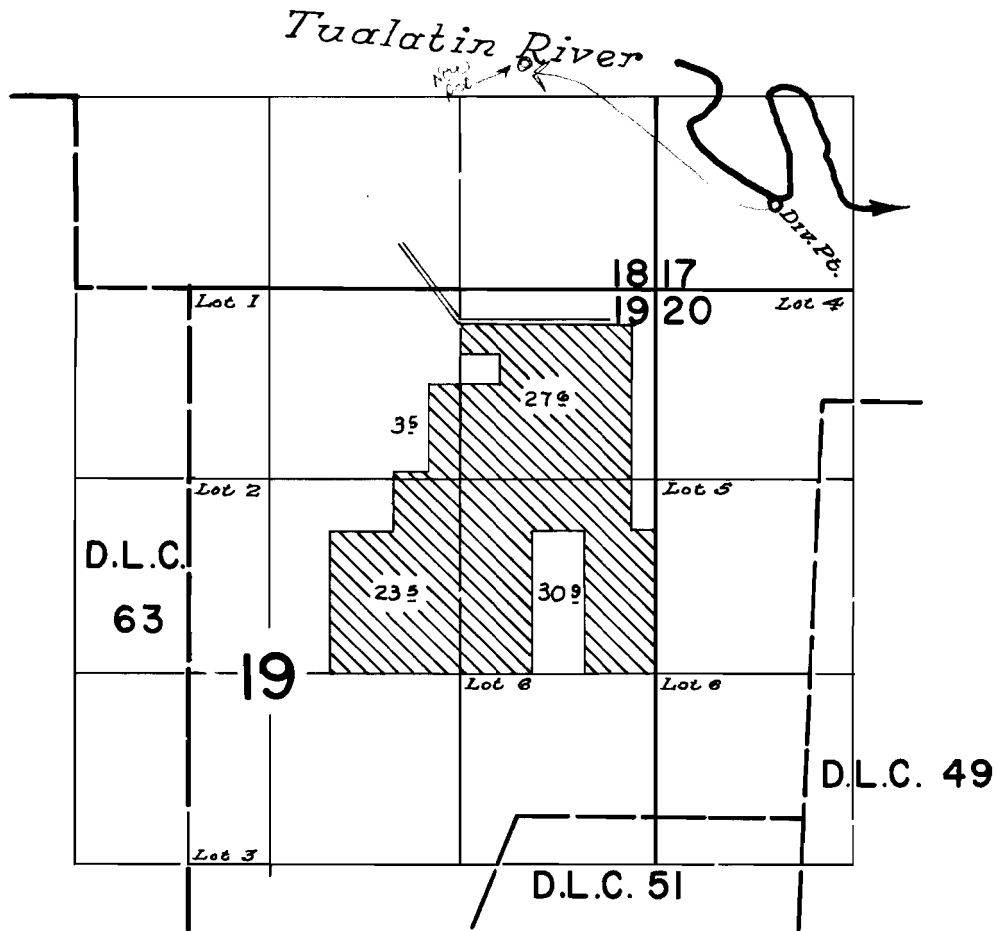

FINAL PROOF SURVEY
UNDER

Application No. 30661... Permit No. 24174...
IN NAME OF

LOUIS HILLECKE

Surveyed June 22 1960, by