


T.3S. R.3S. W.M.

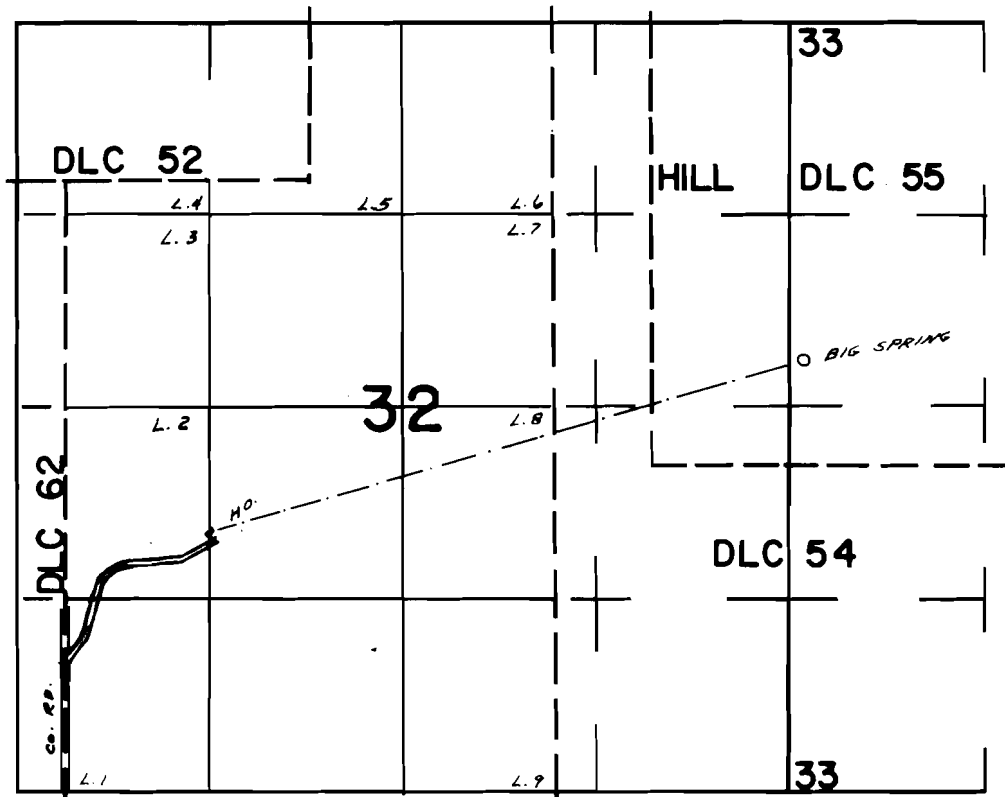

SPRING LOC 320' N. & 80' E. FROM THE W. 1/4 COR. SEC. 33

FINAL PROOF SURVEY
UNDER

Application No. 54053... Permit No. 40426...
IN NAME OF

CHARLES E. & THELMA E. FISHER

Surveyed OCT. 6... 1977, by L.H. NUNN.....

Yamhill-A
DFR-266-211