


T. 4 S., R. 3 W., W.M.

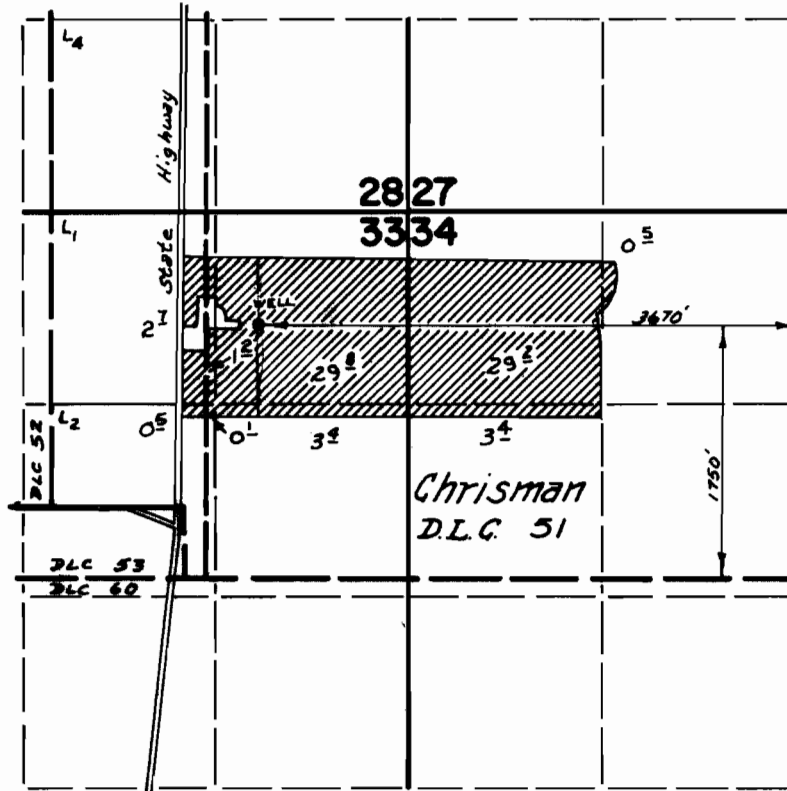

FINAL PROOF SURVEY UNDER

Application No. G-4365 Permit No. G-4117
IN NAME OF

FLOYD J. MCFARLANE

Surveyed Oct 27 1972, by D. Norby