


T.4S. R.3W.W.M.

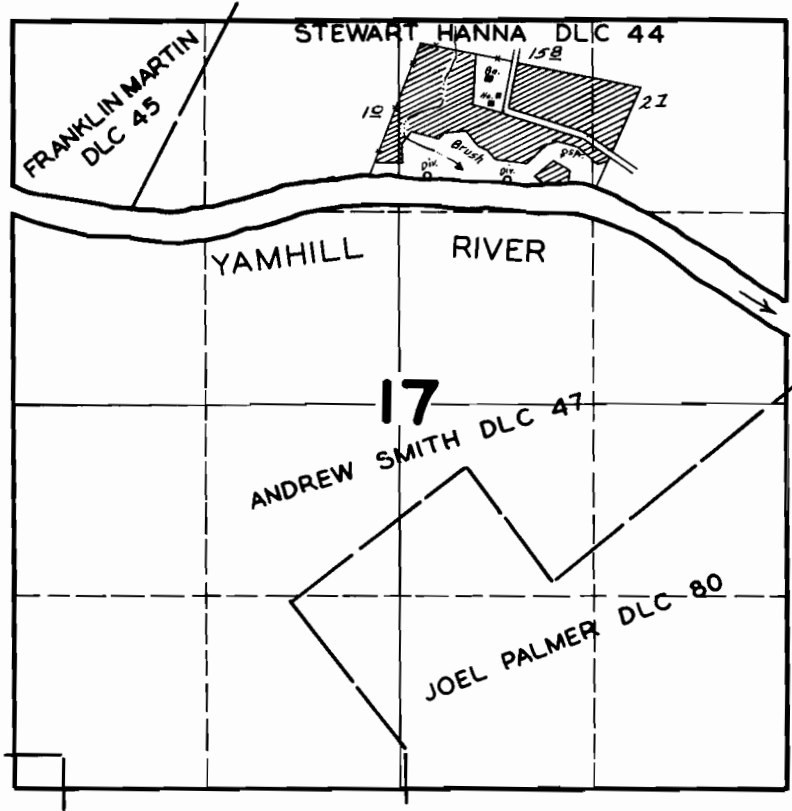

FINAL PROOF SURVEY UNDER

Application No. 19159 Permit No. 14751

IN NAME OF

RICHARD KENNEY

Surveyed JAN. 27, 1945, by *James S. Summell*