


T. 11 S., R. 4 W., W.M.

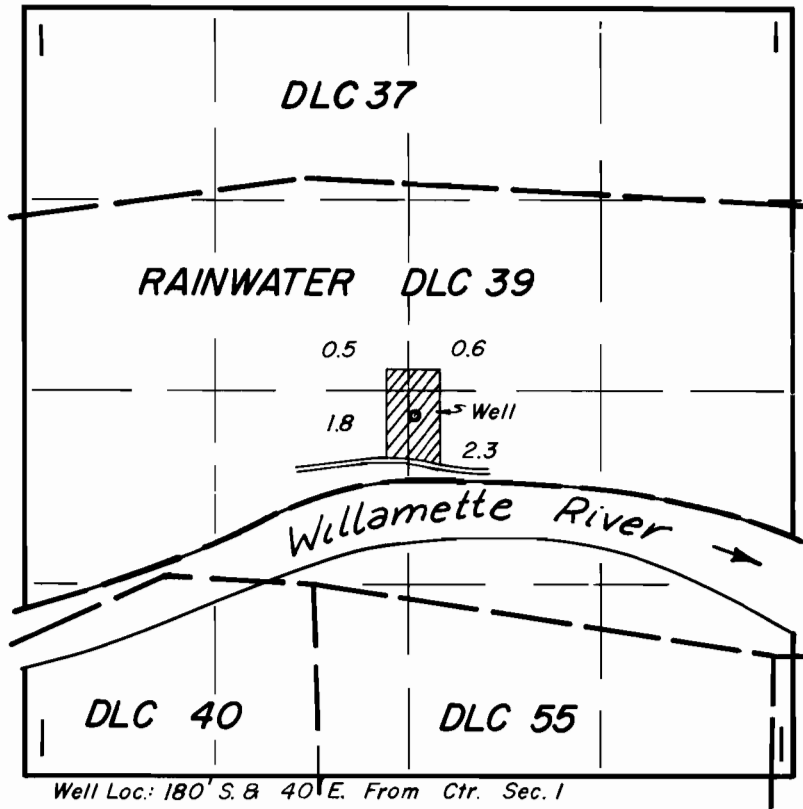

FINAL PROOF SURVEY
UNDER

Application No. G-8063 Permit No. G-7466
IN NAME OF

Kermit O. Beougher

Surveyed Oct. 3, 1978 by S. Applegate