


T.8N. R.3 & 4W. W.M.

COLUMBIA RIV.

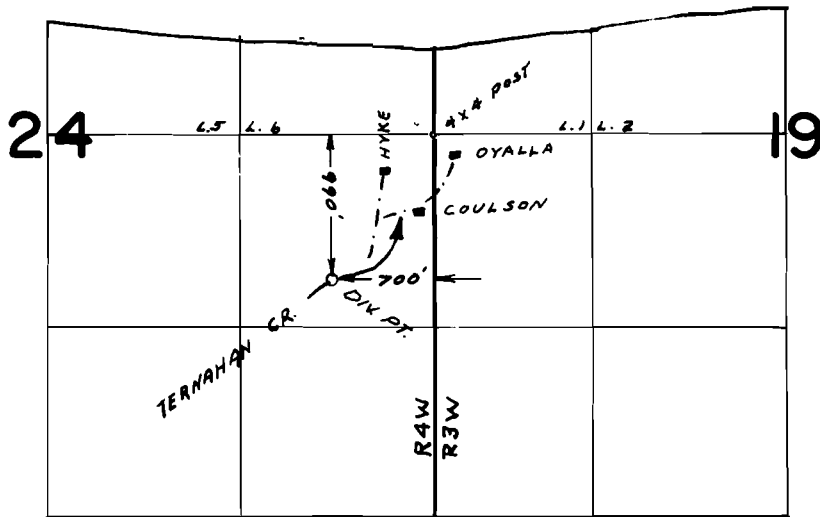

**FINAL PROOF SURVEY**  
UNDER

Application No. 55548... Permit No. 41858.....

IN NAME OF

CHARLES H. COULSON

..... PHILLIP HYKE, WILLIAM OYALLA.....

Surveyed APR. 28. 1978., by L.H. NUNN.....