


T.29S. R.15W. W.M.

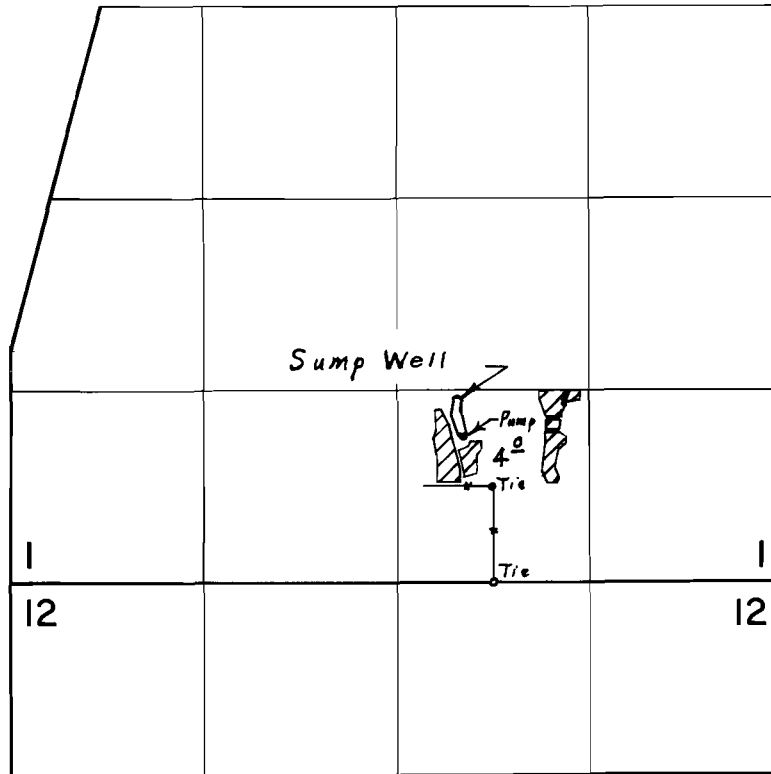

Sump Well located 1130' N. & 2230' W. from S.E. Cor. Sec. 1

FINAL PROOF SURVEY
UNDER

Application No. G-5064 Permit No. G-4774
IN NAME OF

ALMON G. BROWN

Surveyed Aug. 30, 1976, by L. E. Gould