


T.16S. R.24E. W.M.

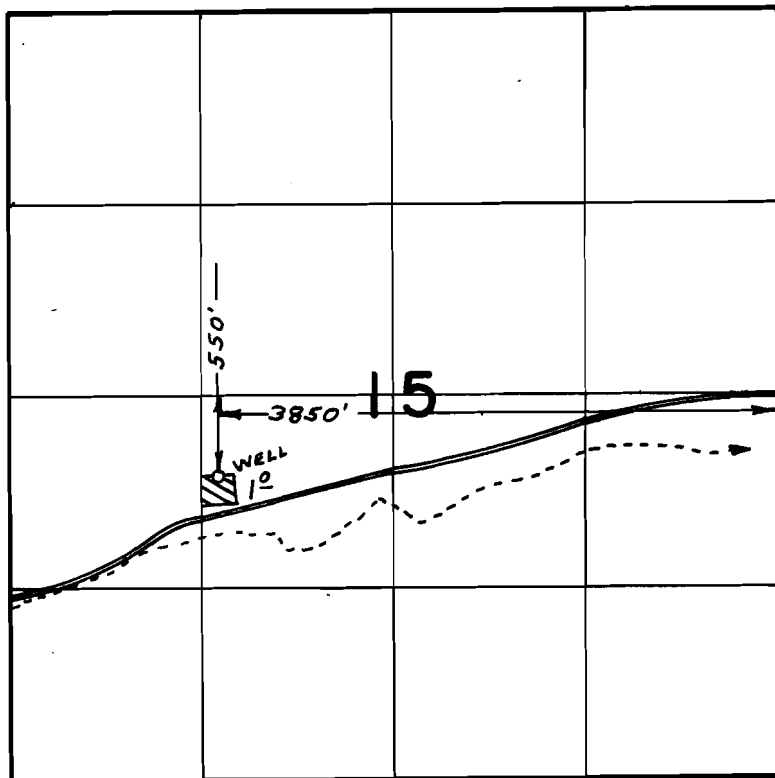

FINAL PROOF SURVEY UNDER

Application No. G-5555... Permit No. G-5430.
IN NAME OF

CROOK COUNTY CEMETARY DISTRICT

Surveyed JUN. 7. 1978., by L.H. NUNN.....