




# T. 41S. R.13W., W.M.

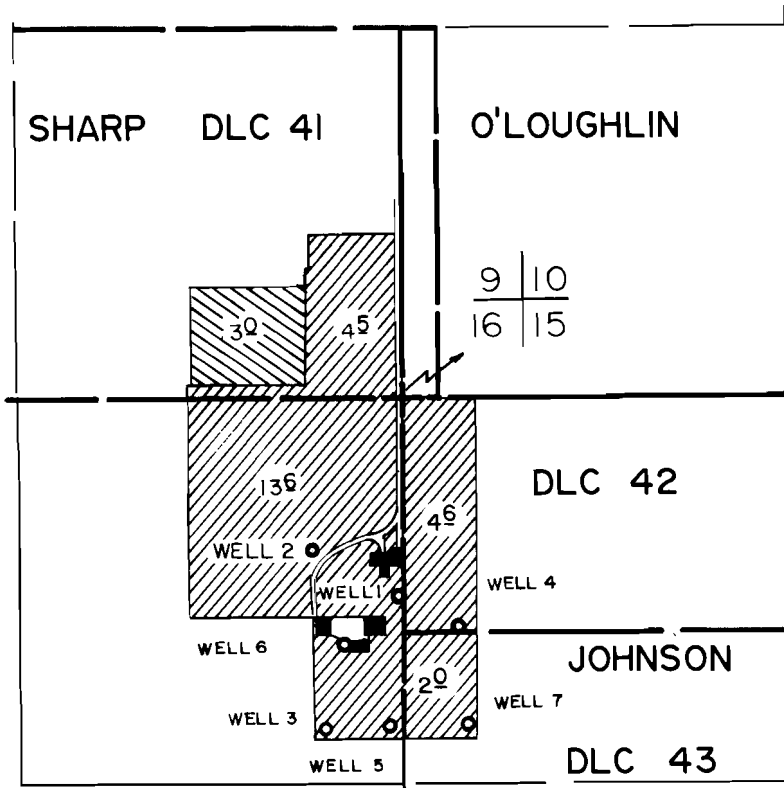

Wells Loc : 1) 680'S & 15'W. ; 2) 520'S. & 310'W. ;  
 3) 1130'S. & 270'W. ; 4) 775'S. & 190'E. ; 5) 1125.S. & 50'W ;  
 6) 845'S. & 205'W. ; 7) 1120'S. & 220'E. - From N. E. Cor. Sec. 16  
 Scale: 8" = 1mi

 G-3900, G-5690  
 G-5691


## FINAL PROOF SURVEY UNDER



Application No. G-4148 Permit No. G-3900  
 G-5376 G-5690  
 G-5664 G-5691  
 IN NAME OF

OREGON PROPAGATING COMPANY

Surveyed JUN. 23. 1975, by MJY

T. 41 S. R. 13 W. W.M.

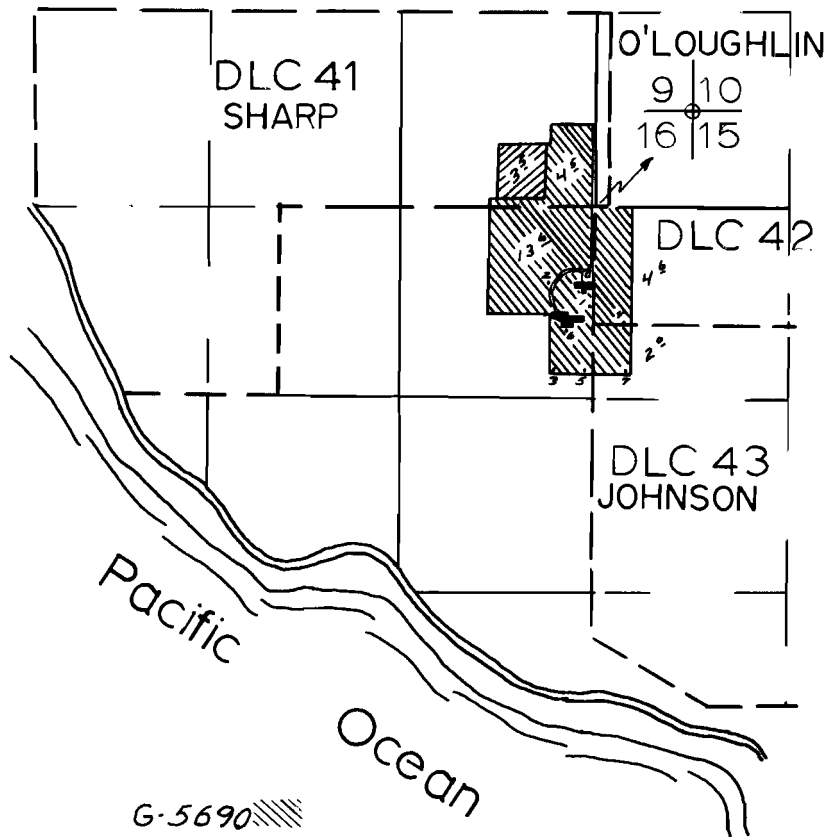

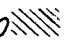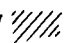G-5690   
 G-5691 

Div. Pts. (wells): 1) 680' S, 15' W; 2) 520' S, 310' W;  
 3) 1120' S, 270' W; 4) 790' S, 190' E; 5) 1120' S, 50' W;  
 6) 840' S, 200' W; 7) 1120' S, 220' E - from the NE cor Sec. 16

**FINAL PROOF SURVEY**  
 UNDER

G-5376                      G-5690  
 Application No. ~~G-5664~~ Permit No. ~~G-5691~~  
 IN NAME OF

OREGON PROPAGATING COMPANY

Surveyed June 23 1975, by M.J.Y.