P - 36513
C - 48346

T. 13S. R.33E. W.M.

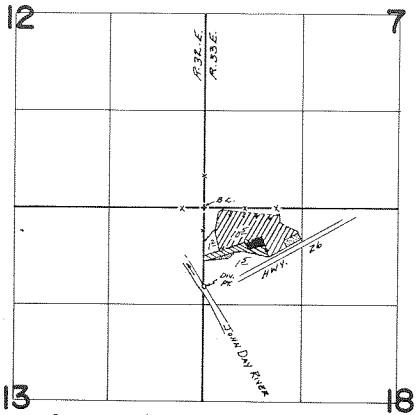

Div. Pt. Loc. - 1090'S & 30'E From NW Cor. Sec. 18

- MITCHELL
- MOODY
- UNDER CERT. #25645

FINAL PROOF SURVEY
UNDER

Application No. 48700 Permit No. 36513
IN NAME OF
DAVID MOODY
GORDON MITCHELL

Surveyed Aug. 25 1978, by J.S.Donaldson

PTS-1978-A3 LEE