


T.37&38 S., R.2 W., W.M.

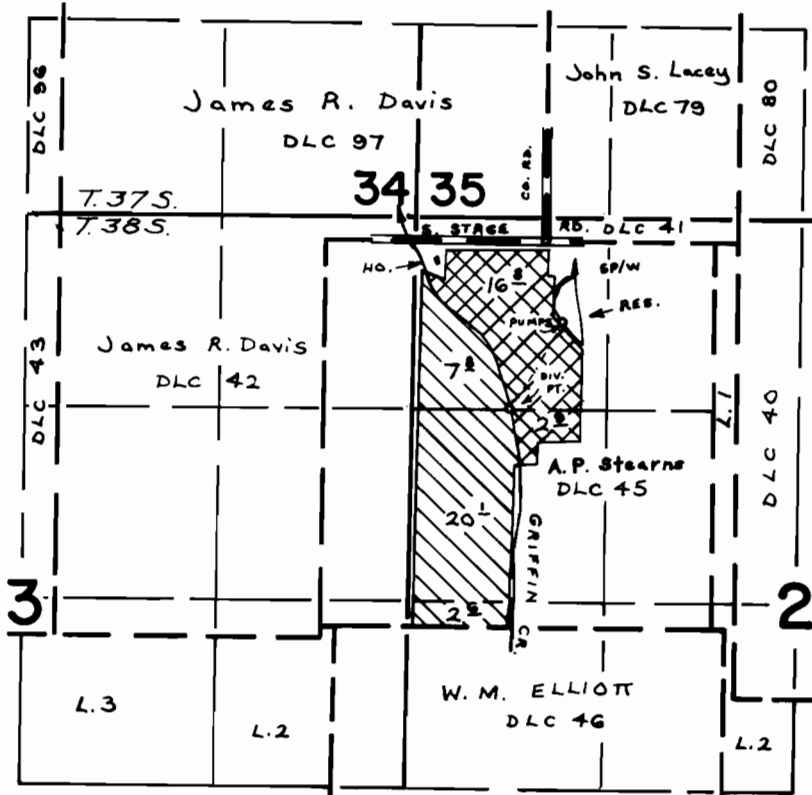

CREEK DIV. PT. - 1320'S. & 670'E., RES. DIV. PT. - 410'S. & 1020'E.,
 BOTH FROM N.W. COR., SEC. 2.

FINAL PROOF SURVEY

UNDER

45781

33845

R-53746

R-6375

Application No. 53747 Permit No. 39622

IN NAME OF

DONALD M. MINEAR

Surveyed OCT. 26 1978, by B. SUND

 PRIMARY

 SUPPL.

D.H.M.

P.T.S. - 1978-14-D