


T. 35 S., R. 3 W., W.M.

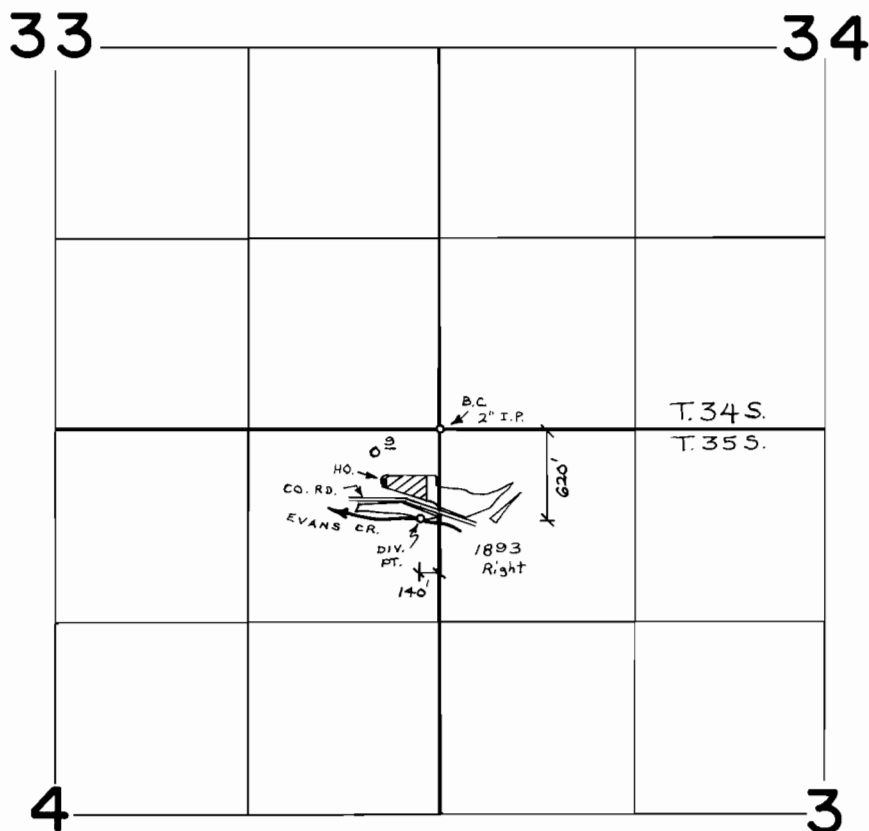

FINAL PROOF SURVEY UNDER

Application No. 50351 Permit No. 39874
IN NAME OF

DAN &/OR LUCY EVENSIZER

Surveyed DEC. 20 19 77, by B. SUND