


T. 38 S., R. 4 W., W.M.

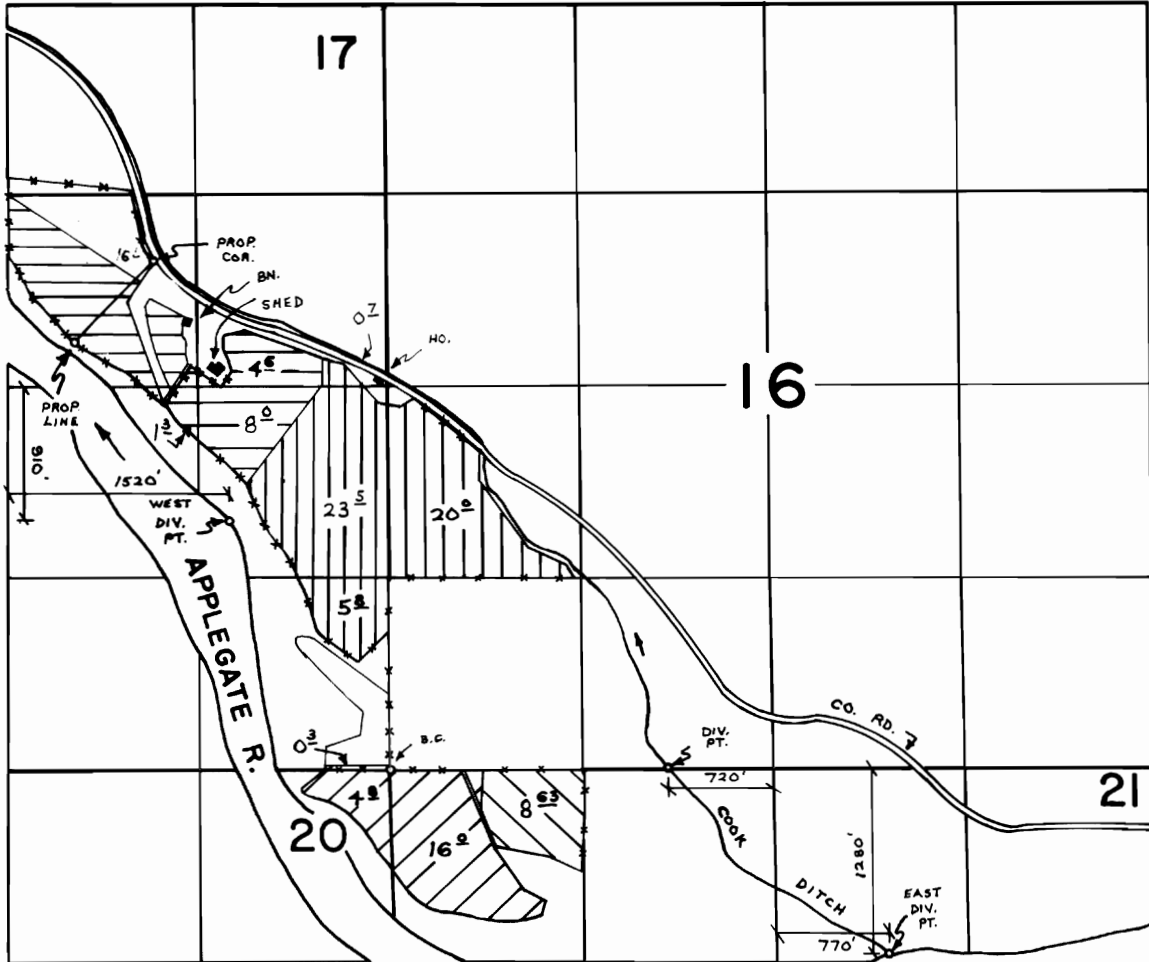

TR. 3753
(1886)



TR. 3755
(1916)



TR. 3754
(1906)

FINAL PROOF SURVEY UNDER



56431 42359
(1977)

Application No. _____ Permit No. _____

IN NAME OF

PATRICK J. CUNNINGHAM

Surveyed AUG. 25 1978, by B. SUND