


# T.36S.R.IE.W.M.

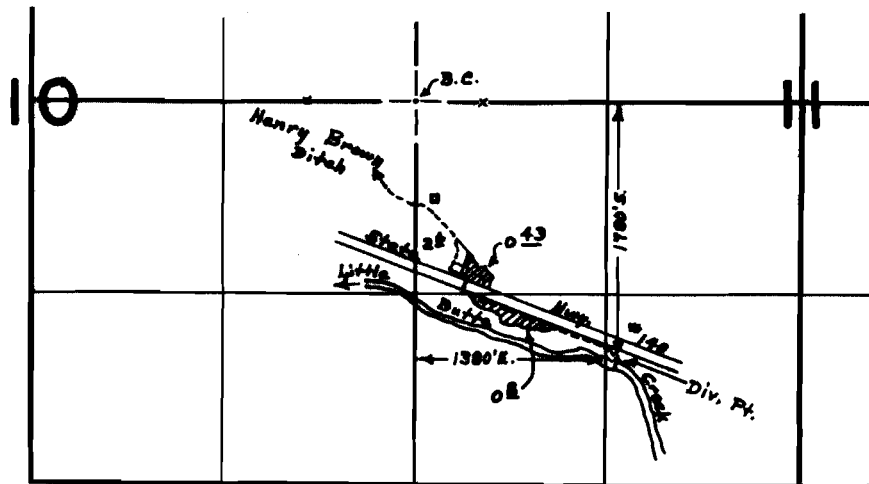

## FINAL PROOF SURVEY UNDER

Transfer No. S-193  
Application No. .... Permit No. ....  
IN NAME OF  
Charles Stanley  
Mrs. Dorothy M. Perry & Leon G. Stanley

Surveyed June 5, 1974, by R. Mucken  
& Sept. 4, 1975 - D. Handix