


T. 37 S., R. 4 W., W. M.

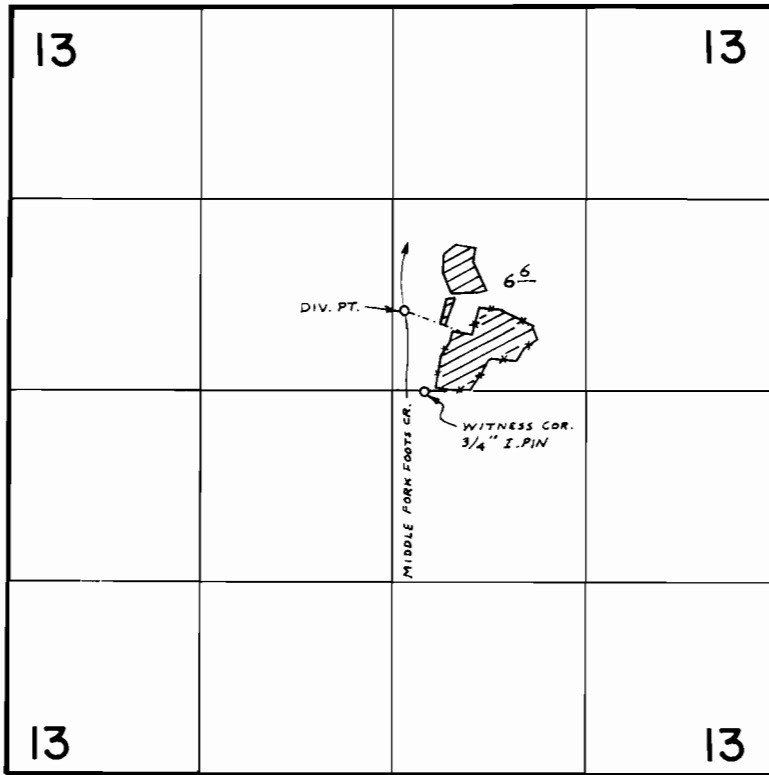

DIV. PT. LOC. : 550' N. & 70' E FROM GEN. 1/4 SEC. 13

FINAL PROOF SURVEY
UNDER

Transfer No. 2556

Application No. Permit No.

IN NAME OF

NEWTON JAMES ELDER

Surveyed SEPT. 29 19 78 by B. SUND