


# T. 38 S., R. 4 W., W.M.

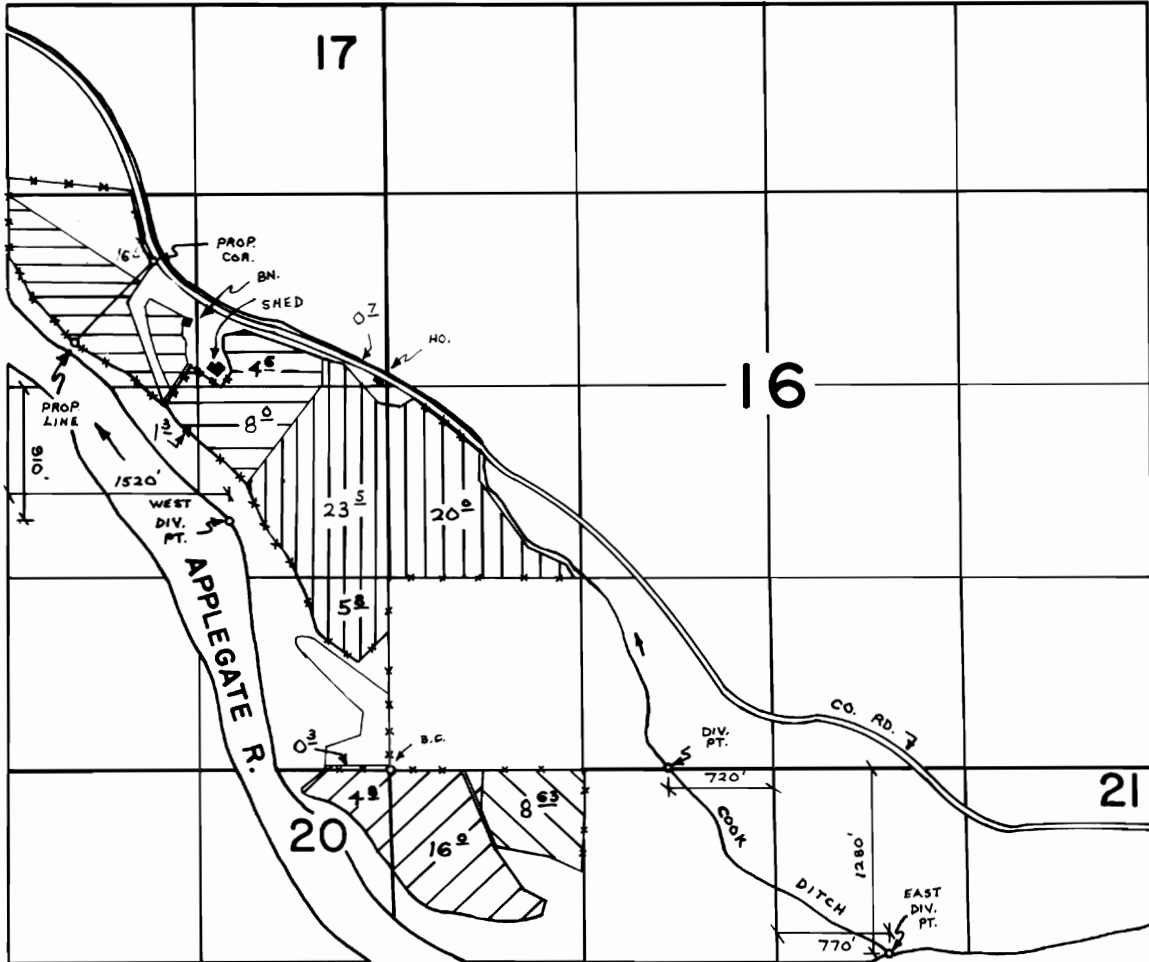

TR. 3753  
(1886)



TR. 3755  
(1916)



TR. 3754  
(1906)

## FINAL PROOF SURVEY UNDER



56431 42359  
(1977)

Application No. .... Permit No. ....

IN NAME OF

PATRICK J. CUNNINGHAM

Surveyed AUG. 25 1978, by B. SUND