


T. 38 S., R. 4 W., W.M.

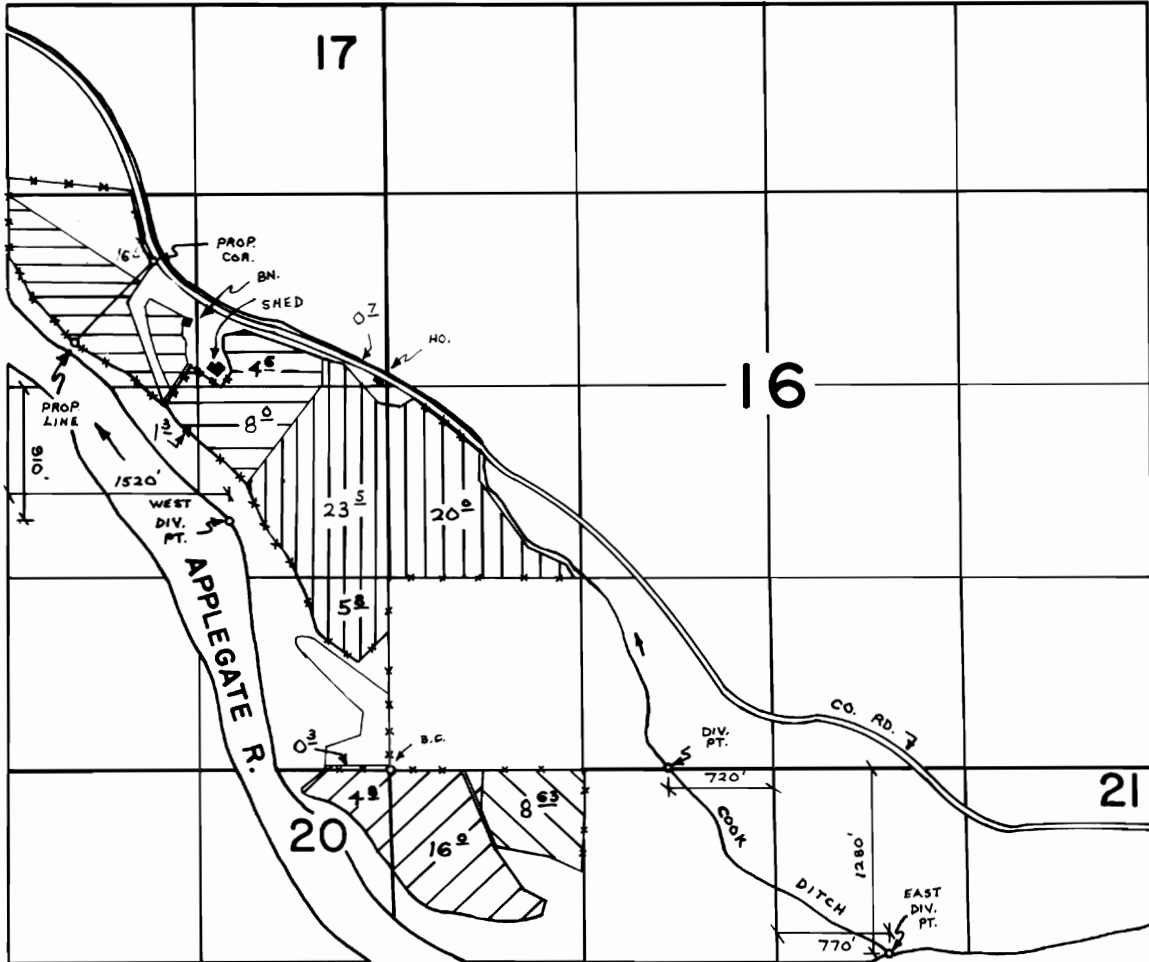

TR. 3753
(1886)



TR. 3755
(1916)



TR. 3754
(1906)

FINAL PROOF SURVEY UNDER



56431 42359
(1977)

Application No. Permit No.

IN NAME OF

PATRICK J. CUNNINGHAM

Surveyed AUG. 25 1978, by B. SUND