


T.39S. R.IIE., W.M.

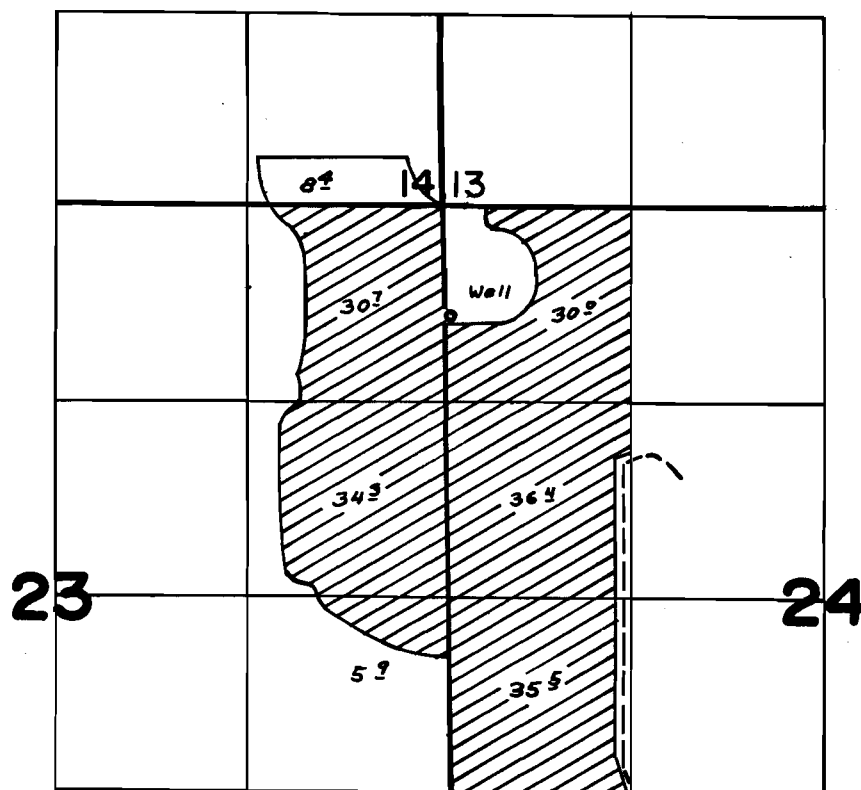

Well Loc. 760'S. & 60'E. From N.W. Cor. Sec. 24

FINAL PROOF SURVEY UNDER

Application No. G-7393. Permit No. G-6873.
IN NAME OF

RAJNUS BROTHERS

Surveyed AUG. 1, 1978, by S. P. APPLGATE