


T.39S. R.9E., W.M.

Klamath R. wells

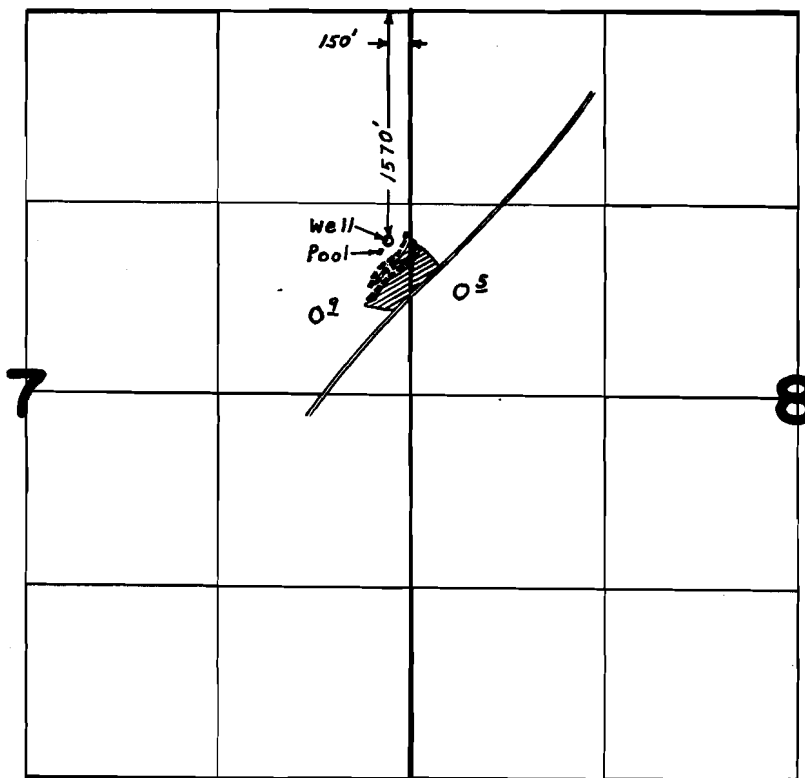

FINAL PROOF SURVEY UNDER

Application No. G-8217... Permit No. G-7554.
IN NAME OF

.....ETHEL M. STRANSKE.....

Surveyed JUL. 26... 1978., by S.P. APPLGATE