


T. 16 S., R. 7 W., W.M.

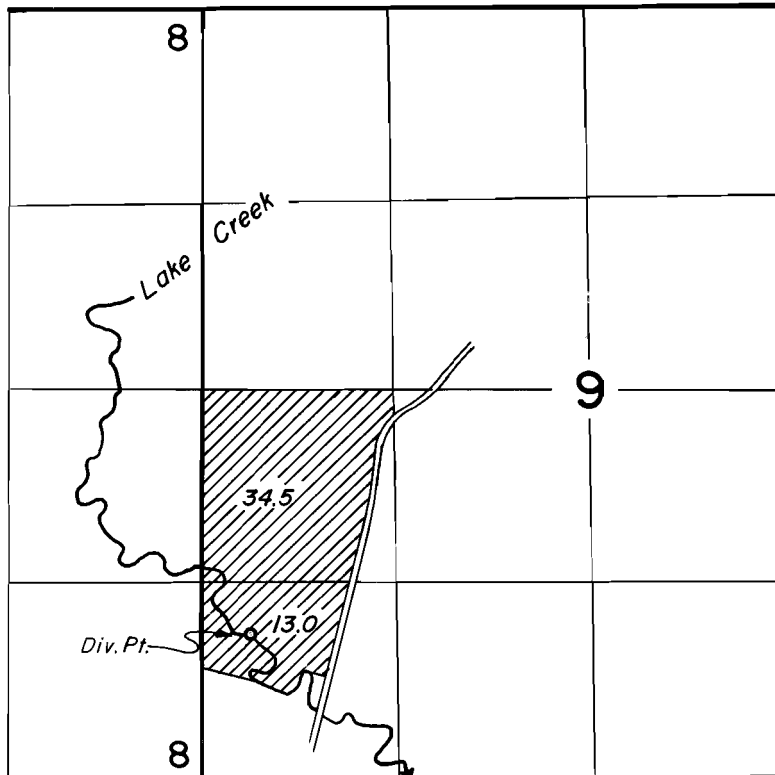

DIV. PT. LOC.: 1680' S. & 340' E. From W. 1/4 Cor. Sec. 9

FINAL PROOF SURVEY
UNDER

Application No. 44019 Permit No. 32903
IN NAME OF

ROLLIN B. EVANS

Surveyed May 25, 1978, by L. NUNN