


T.17S. R.1W. W.M.

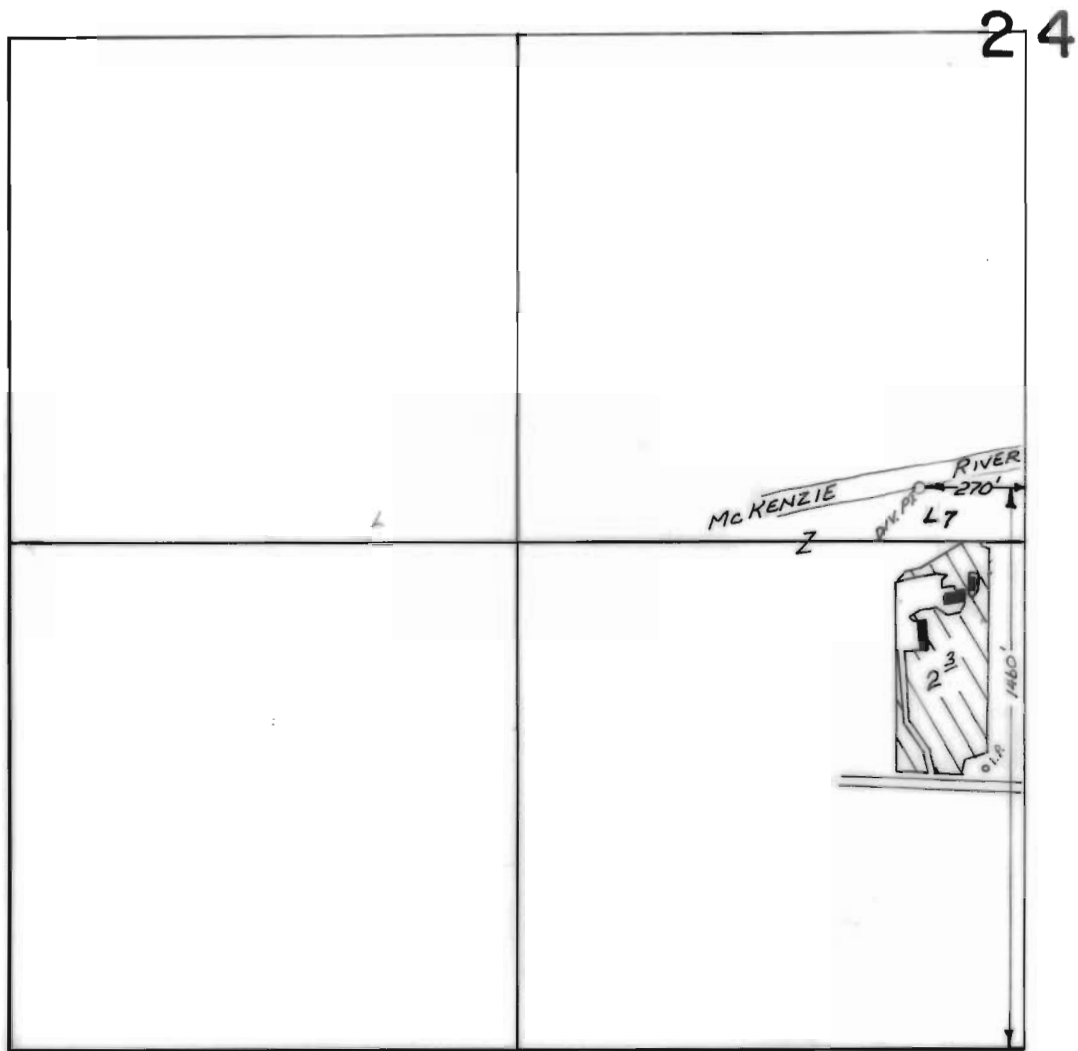

SCALE 1"=500'

FINAL PROOF SURVEY
UNDER

Application No. 47822 Permit No. 35243
IN NAME OF

RICHARD L. KILBRIDE

Surveyed SEP. 2 1977, by L.H. NUNN