


T.17 S., R.5 W., W.M.

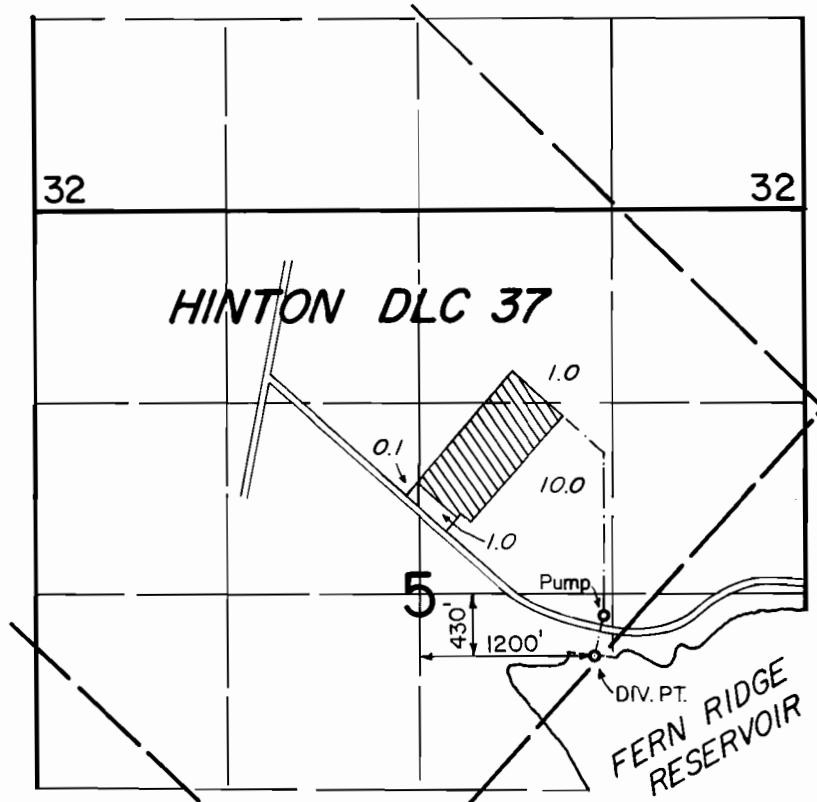

FINAL PROOF SURVEY
UNDER

Application No. 48831 Permit No. 36945
IN NAME OF

W. D. & G. J. WALTON

Surveyed MAY 11, 1978, by L. NUNN