


T. 16 S., R. 7 W., W.M.

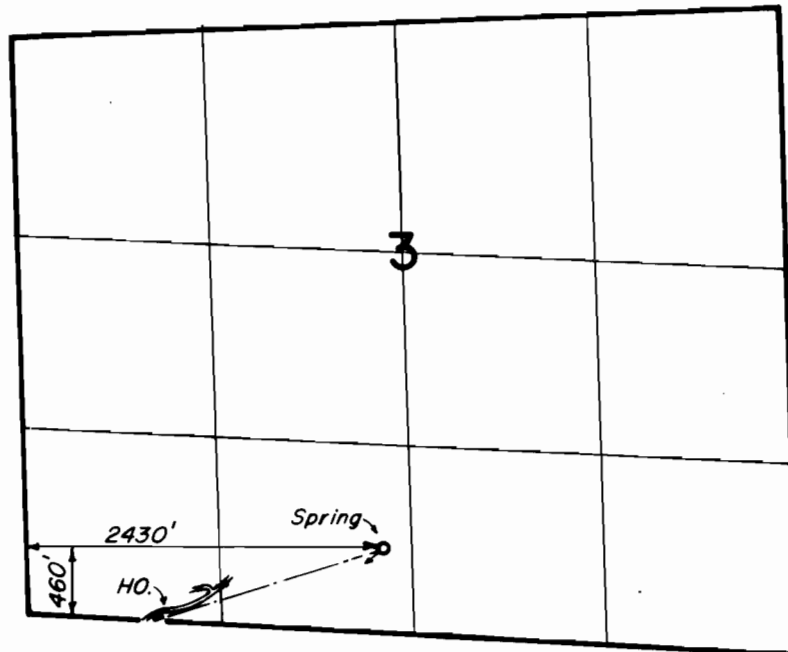

FINAL PROOF SURVEY
UNDER

Application No. 49179 Permit No. 36866
IN NAME OF

DONALD C. & FLORENCE M. SANFORD

Surveyed MAY 24, 1978, by L. NUNN