


T. 16S., R. 5W., W.M.

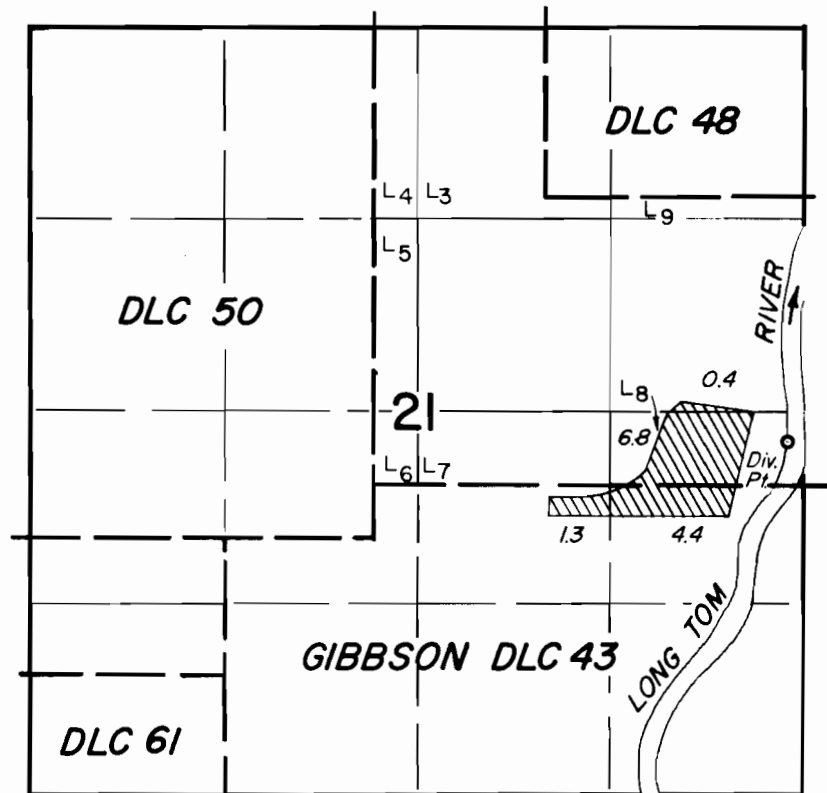

DIV. PT. LOC.: 2420' N. & 100' W. From SE. Cor. Sec. 21

FINAL PROOF SURVEY
UNDER

Application No. 49250 Permit No. 36913
IN NAME OF

K. E. & A. E. HARRIS

Surveyed MAY 9, 1978, by L. NUNN